

# SUPERIOR MARKETPLACE

PLANNED DEVELOPMENT / ZONE DISTRICT PLAN AMENDMENT #4  
NEW PLAN EXCEL REALTY TRUST, INC.

THE MULHERN GROUP, LTD.

A PORTION OF THE SE 1/4 OF SECTION 13 AND THE N 1/2  
OF THE NE 1/4 OF SECTION 24, T15, R70W OF THE 6TH P.M.

AREA OF AMENDMENT #4

### SITE DEVELOPMENT CRITERIA

**Maximum Building Height:**  
Detail: 50' (Not parapet height)  
Theater building: 50' (only entrance, tower, or sloped roof)

**Setback Building:** 50'

**Setback Building:**  
From Public R.O.W.: 50' min.  
From Internal Property Lines: 0'

**Min. Separation Between Buildings:** 0'

**Building Setbacks:**  
From All Public R.O.W.: 50' min.  
From Internal Property Lines: 50' min.

**Typical Building Height:** 4' x 10'



**Typical Building Spacing:** 14' x 10' (includes side)

**Typical Building Width:** 34' wide

**Minimum Setbacks:** 50' min. (vertical to horizontal)

\* Rear of in-line buildings facing a R.O.W. shall be setback a minimum of 50' from R.O.W.  
\* Rear of buildings at 750' Street shall be setback a minimum of 50' from R.O.W.

### VICINITY MAPS

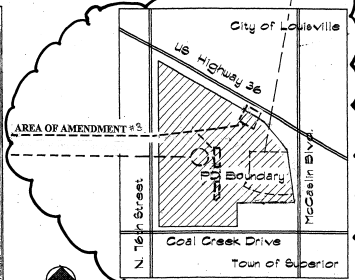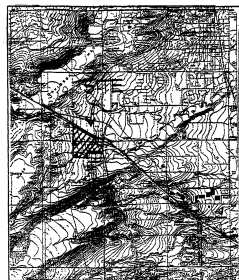

### LAND USE TABLE

PDMA Site Area:	97.8 Acres	100%	Net Right-of-Way Area:	11.6 Acres	18.0%
Future Development, Paved:	91.1 Acres	93%	Medium-Density:	5.64 Acres	8.3%
Gross Development Area:	68.7 Acres	90.7%	High-Density:	2.28 Acres	3.4%
Gross Development Area includes R.O.W. areas as well as Retail Development:			Residential Medium Density:	0.40 Acres	0.6%
Density:	Commercial: 7,068 s.f./acre (P.A.M. 06.117)		Residential Single-Family:	0.66 Acres	1.0%
Building Area Subtotal:	876,479 s.f.	17.4%	Neighborhood Office:	0.00 Acres	0.0%
Unimproved Open Space:	32.8 Acres	33.7%	Neighborhood Service:	0.00 Acres	0.0%
Other Open Space:	32.8 Acres	33.7%	Neighborhood Retail:	0.00 Acres	0.0%
Walks in front of buildings:	Planned less than 6,000 s.f.				
Planned less than 6,000 s.f. (includes less than 400 s.f.):					
Public Area Subtotal:	67.1 Acres	88.1%			
Residence, drive, loading area, and parking lots:					
Total:	68.7 Acres	100% of gross			
Building Area/Development:					
Provided: Total site spaces:	4,361 Spaces				
Retail Development:	2,961 Spaces	5.7/1000 s.f.			
300 Public-Use:	400 Spaces				
Required Below:					
Detail: 4.8 spaces/1000 s.f. (min.)					
Transacting Restaurants: 1.8 spaces/1000 s.f. (min.)					

### ENTIRE PD BOUNDARY

A TRACT OF LAND IN THE N 1/2, NE 1/4, SECTION 24 AND IN THE S 1/2, SE 1/4, SECTION 13, ALL IN TOWNSHIP 1 SOUTH, RANGE 70 WEST OF THE 6TH PRINCIPAL MERIDIAN, COUNTY OF BOULDER, STATE OF COLORADO, DESCRIBED AS FOLLOWS:

COMMENCING AT THE NORTHEAST CORNER OF SECTION 24, T15, R70 W, THENCE S89°40'00" E, ALONG THE NORTH LINE OF THE NE 1/4 OF SAID SECTION 24, A DISTANCE OF 845.00 FEET TO THE NORTHEAST CORNER OF THAT TRACT OF LAND DESCRIBED ON FILM 628 AS RECEPTION NO. 868660 OF THE RECORDS OF BOULDER COUNTY, COLORADO, WHICH CORNER IS THE TRUE POINT OF BEGINNING;

THENCE S89°40'00" E, ALONG THE EASTERN LINE OF THAT TRACT OF LAND DESCRIBED ON SAID FILM 628 AS RECEPTION NO. 868660, A DISTANCE OF 242.56 FEET; THENCE S89°47'24" E, CONTINUING ALONG THE EASTERN LINE OF THAT TRACT OF LAND DESCRIBED ON SAID FILM 628 AS RECEPTION NO. 868660, A DISTANCE OF 364.72 FEET; THENCE S89°12'21" E, CONTINUING ALONG THE EASTERN LINE OF THAT TRACT OF LAND DESCRIBED ON SAID FILM 628 AS RECEPTION NO. 868660, A DISTANCE OF 508.00 FEET TO THE SOUTHERN CORNER OF THAT TRACT OF LAND DESCRIBED ON SAID FILM 628 AS RECEPTION NO. 868660, WHICH CORNER IS ON THE NORTH LINE OF MAPLE STREET IN JENNY'S ADDITION TO THE TOWN OF SUPERIOR, RECORDED IN PLAT BOOK 5 AT PAGE 36 OF THE RECORDS OF BOULDER COUNTY, COLORADO; THENCE S89°48'20" E, ALONG THE NORTH LINE OF SAID MAPLE STREET, A DISTANCE OF 129.63 FEET TO THE WEST LINE OF PORTER AVENUE IN SAID JENNY'S ADDITION TO THE TOWN OF SUPERIOR; THENCE S91°14'07" E, ALONG THE WEST LINE OF SAID PORTER AVENUE, A DISTANCE OF 386.60 FEET TO THE SOUTH LINE OF SAID WEST LINE OF SAID SECTION 24; THENCE S89°42'37" E, ALONG THE SOUTH LINE OF SAID N 1/2, NE 1/4, A DISTANCE OF 1388.71 FEET TO THE SOUTHWEST CORNER OF SAID N 1/2, NE 1/4; THENCE N91°11'07" E, ALONG THE WEST LINE OF SAID N 1/2, NE 1/4, A DISTANCE OF 1388.50 FEET TO THE NORTHEAST CORNER OF SAID N 1/2, NE 1/4; THENCE N90°06'46" E, ALONG THE WEST LINE OF THE S 1/2, SE 1/4, SECTION 13, T15, R70 W, A DISTANCE OF 1348.00 FEET TO THE SOUTHWESTERN LINE OF U.S. HIGHWAY NO. 36 AS DESCRIBED IN BOOK 878 AT PAGE 268 OF THE RECORDS OF BOULDER COUNTY, COLORADO; THENCE S89°11'15" E, ALONG THE SOUTHWESTERN LINE OF U.S. HIGHWAY NO. 36, AS DESCRIBED IN SAID BOOK 878 AT PAGE 268, A DISTANCE OF 847.76 FEET TO THE SOUTH LINE OF THAT TRACT OF LAND DESCRIBED IN BOOK 424 AT PAGE 347 OF THE RECORDS OF BOULDER COUNTY, COLORADO; THENCE N90°06'46" E, ALONG THE SOUTH LINE OF THAT TRACT OF LAND DESCRIBED IN SAID BOOK 424 AT PAGE 347, A DISTANCE OF 136 FEET TO THE SOUTHWESTERN LINE OF U.S. HIGHWAY NO. 36 AS DESCRIBED IN BOOK 878 AT PAGE 267 OF THE RECORDS OF BOULDER COUNTY, COLORADO; THENCE ALONG THE SOUTHWESTERN LINE OF U.S. HIGHWAY NO. 36 AS DESCRIBED IN SAID BOOK 878 AT PAGE 267, THE FOLLOWING COURSES AND DISTANCES:

S89°06'10" E A DISTANCE OF 887.67 FEET; THENCE N89°50'50" E, A DISTANCE OF 10.00 FEET; THENCE S89°06'10" E A DISTANCE OF 360.00 FEET; THENCE S83°30'31" E A DISTANCE OF 587.91 FEET TO THE NORTH LINE OF SAID N 1/2, NE 1/4;

THENCE, DEPARTING FROM THE SOUTHWESTERN LINE OF SAID U.S. HIGHWAY NO. 36, N89°06'40" E, ALONG THE NORTH LINE OF SAID N 1/2, NE 1/4, A DISTANCE OF 0.97 FEET TO THE TRUE POINT OF BEGINNING, COUNTY OF BOULDER, STATE OF COLORADO, CONTAINING 84.230 ACRES MORE OR LESS.

**NOTES:**  
HEARINGS ARE BASED UPON THE NORTH LINE OF THE NE 1/4, SECTION 24, T15, R70W HAVING A BEARING OF S89°04'17" (TRUE MERIDIAN).  
BOUNDARY DIMENSIONS ARE TAKEN FROM SURVEY BY BREKEL BARRELL ENGINEERS/SURVIVORS DATED 12/8/84, JOB NO. 4833-25.

### AMENDED PD BOUNDARY

SUPERIOR MARKETPLACE, FILING 6, LOT 6:

COMMENCING AT THE NORTHEAST CORNER SECTION 24, THENCE S89°48'49" A DISTANCE OF 872.28 FEET TO A POINT ON THE WESTERN RIGHT-OF-WAY LINE OF THE BOULDER-GLENVIEW TURNPIKE, U.S. HIGHWAY NO. 36, BOOK 878, PAGES 267 AND 268, STATE OF COLORADO; THENCE S89°12'21" E, ALONG SAID RIGHT-OF-WAY A DISTANCE OF 129.37 FEET; TO A POINT ON SAID WESTERN RIGHT-OF-WAY SAID POINT BEING THE POINT OF BEGINNING; THENCE ALONG SAID WESTERN RIGHT-OF-WAY THE FOLLOWING 4 COURSES:

1. S90°07'15" A DISTANCE OF 17.44 FEET;
2. S24°48'24" E A DISTANCE OF 114.32 FEET;
3. S42°30'57" E A DISTANCE OF 142.70 FEET;
4. S73°20'48" E A DISTANCE OF 121.38 FEET;

THENCE LEAVING SAID WESTERN RIGHT-OF-WAY ALONG THE WESTERN LINE TRACT M 52019387W A DISTANCE OF 421.28 FEET TO A POINT ON THE NORTHERLY RIGHT-OF-WAY OF MARSHALL ROAD; THENCE ALONG SAID RIGHT-OF-WAY THE FOLLOWING 2 COURSES:

1. S88°48'20" W A DISTANCE OF 485.17 FEET TO A POINT OF CURVATURE TO THE RIGHT;
2. ALONG SAID CURVE WHOSE RADIUS IS 388.00 FEET AND AN INCLUDED ANGLE OF 34°40'10" A DISTANCE OF 241.94 FEET TO A POINT ON SAID RIGHT-OF-WAY AND A POINT ON THE EASTERN BOUNDARY OF TRACT L.

THENCE LEAVING SAID RIGHT-OF-WAY ALONG SAID EASTERN BOUNDARY THE FOLLOWING 2 COURSES:

1. N04°13'39" W A DISTANCE OF 70.86 FEET; TO A POINT OF CURVATURE TO THE RIGHT, AND A POINT ON THE EASTERN BOUNDARY OF LOT 4;
2. ALONG SAID CURVE TO THE RIGHT WHOSE RADIUS IS 261.23 FEET WITH AN INCLUDED ANGLE OF 87°08'59" A DISTANCE OF 87.01 FEET;

TO A POINT ON THE NORTHERLY BOUNDARY TRACT L, THENCE LEAVING SAID EASTERN BOUNDARY ALONG SAID NORTHERLY LINE N87°02'37" W A DISTANCE OF 38.36 FEET THENCE ALONG AN ARC OF A CURVE TO THE LEFT WHOSE RADIUS IS 220.50 FEET WITH AN INCLUDED ANGLE OF 22°23'11" A DISTANCE OF 80.11 FEET TO A POINT ON THE EASTERN BOUNDARY LOT 4 THENCE ALONG SAID EASTERN BOUNDARIES OF LOT 3 AND SAID LOT 4 N90°06'46" E A DISTANCE OF 347.88 FEET TO A POINT ON SAID EASTERN BOUNDARY OF LOT 3; AND A POINT ON THE SOUTHERLY BOUNDARY OF LOT 8; THENCE ALONG SAID SOUTHERLY BOUNDARY THE FOLLOWING 2 COURSES:

1. S89°06'10" E A DISTANCE OF 363.63 FEET;
2. N69°10'36" E A DISTANCE OF 71.62 FEET; TO THE POINT OF BEGINNING.

SAID PARCEL CONTAINS 411,218 SQ. FT. (9.41 ACRES) MORE OR LESS.

### TOWN BOARD OF TRUSTEES' CERTIFICATE

Approved this 15th day of JANUARY, A.D. 2003,  
by the Board of Trustees, Superior, Colorado. This approval is with the understanding that all expenses involving necessary improvements for all utility services, parking, grading, landscaping, curbs, gutters, street lights, street signs, and sidewalks, shall be financed by others and not the Town of Superior.

Tom Mulkey Mayor  
Tom Mulkey Town Clerk

### PLANNING COMMISSION CERTIFICATE

Approved this 16th day of November, A.D. 2002

Joseph E. Smith  
Chairman, Superior Planning Commission

### TOWN CLERK'S CERTIFICATE

I hereby certify that this instrument was filed in my office at 620 So. Peacock St. on this 15th day of January, A.D. 2003, and is duly recorded.

Tom Mulkey  
Town Clerk

### CERTIFICATE OF OWNERSHIP

I certify that NEW PLAN EXCEL REALTY TRUST, INC. is the owner of portions of the property, and has the right to immediate possession of the remainder of the property under common law. I consent to the Superior Court-Common Law, and I consent to the above P.D.

By Thomas A. Mulkey President  
New Plan Excel Realty Trust, Inc. President

The foregoing instrument was acknowledged before me this 12th day of January, A.D. 2003 by Thomas A. Mulkey as manager of New Plan Excel Realty Trust, Inc. a corporation and my commission expires 9/26/07

Notary Public

Memo of Record recorded on  
April 16, 2003 At Boulder County  
Clerks office  
Recording # 2426256

<b>DEVELOPER</b>  NEW PLAN EXCEL REALTY TRUST, INC.  563 W. 500 South Suite #440 Bountiful, UT 84010  Tom Mulkey (801) 296-6033	<b>ARCHITECT/PLANNER</b>  The Mulhern Group, Ltd.  1750 BLAKE STREET SUITE 455 DENVER, COLORADO 80202 909.297.2334 FAX : 909.292.2501 MICHAEL MULHERN DWAYNE DALE	<b>CIVIL ENGINEER</b>  Hydro-Triad/V3, Colorado  200 UNION BLVD. SUITE 200 LAKEWOOD, COLORADO 80228 909.989.0088 FAX : 909.989.9938 DOUG CRAIG JOHN BURKEY	<b>LANDSCAPE ARCHITECT</b>  Norris/Dullea  610 WEST COLPAX DENVER, COLORADO 80204 909.496.1165 FAX : 909.492.1166 DOUG CRAIG JOHN BURKEY	The information, drawings, intent, and concepts contained in this package are the property of the Ellman Companies and their use by any other party is strictly prohibited without the permission of the Ellman Companies.	REVISED JANUARY 14, 2000 REVISED MARCH 1, 2000 REVISED FEBRUARY 1, 2001 REVISED MARCH 20, 2001 REVISED APRIL 5, 2001 REVISED NOVEMBER 14, 2001 REVISED JUNE 28, 2002 REV. SEPT 19, 2002  COVER SHEET : 1 OF 16 Page 1 of 16
---	--	---	---	--	---

# SUPERIOR MARKETPLACE

PLANNED DEVELOPMENT/ZONE DISTRICT SITE PLAN AMENDMENT NO. 4  
NEW PLAN EXCEL REALTY TRUST, INC.

THE MULHERN GROUP, LTD.

THE MULHERN GROUP LTD.  
ARCHITECTURE • PLANNING • INTERIOR



1730 BLAKE STREET SUITE 435  
DENVER, COLORADO 80202  
303-297-3354 FAX 303-292-2601

CDOT Maint. Facility

Single Family Residential

WESTERN HIGHWAY OF BALANCE SUBDIVISION

Proposed Sycamore Street  
60' R.O.W.

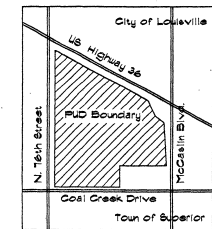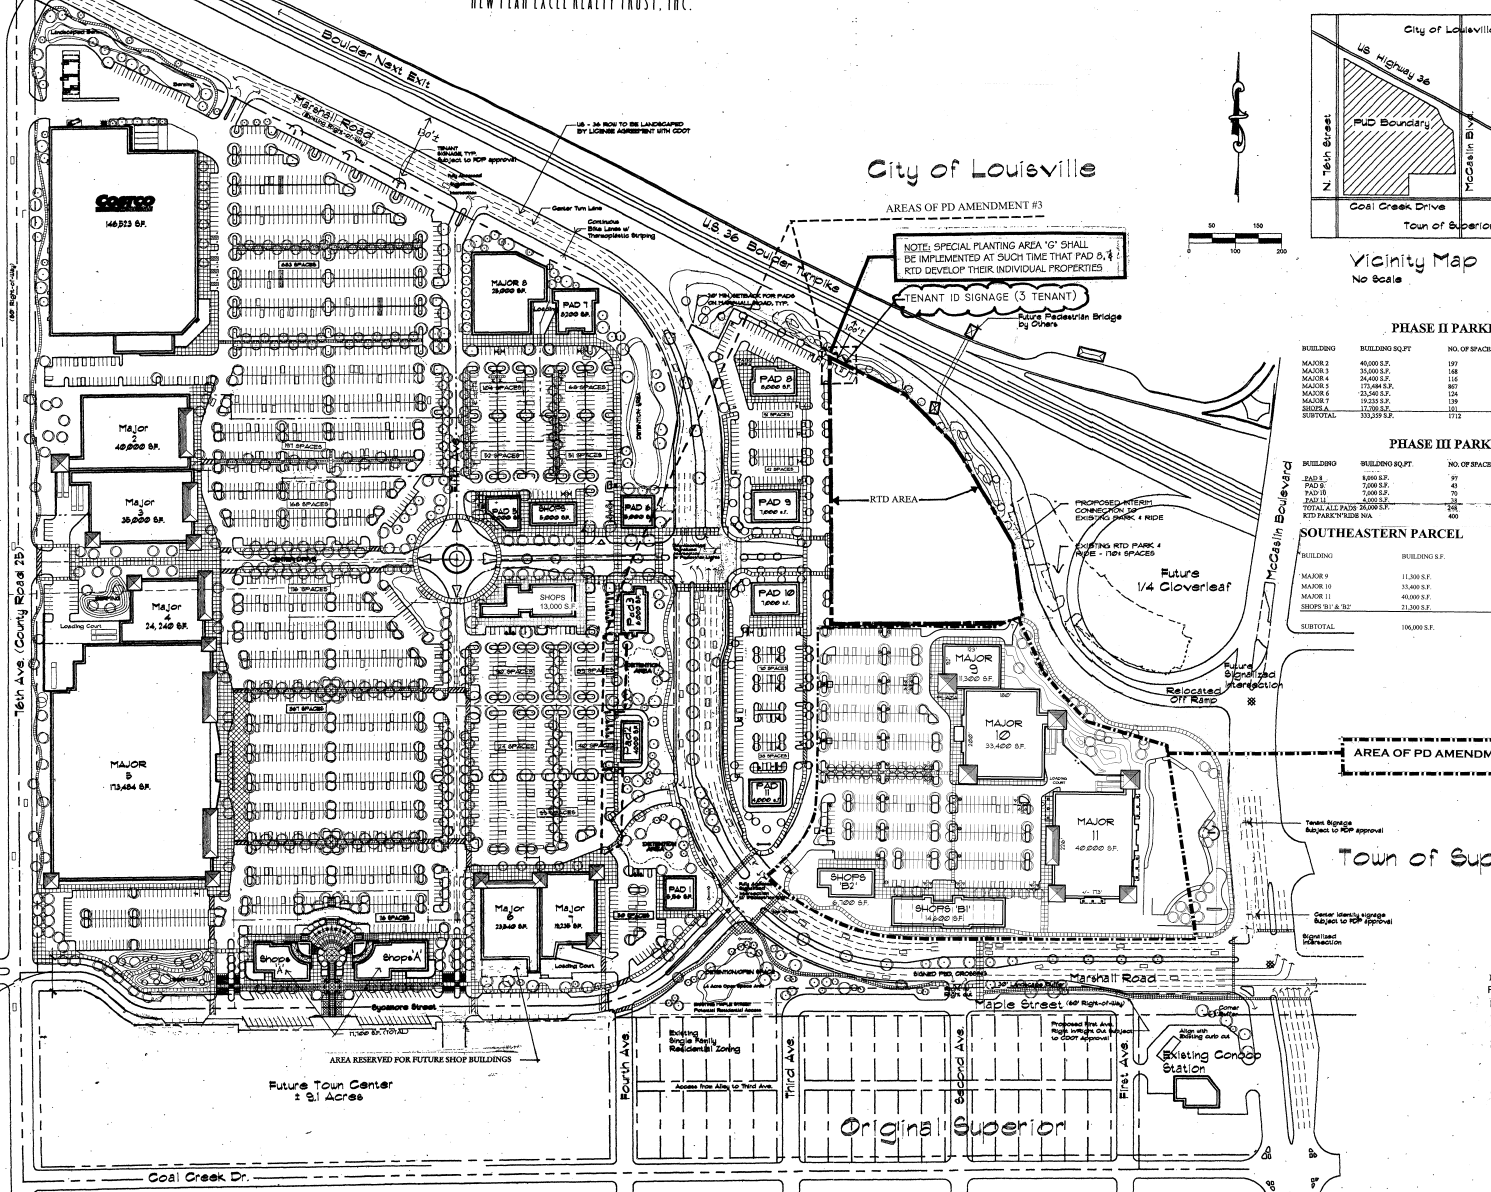

Vicinity Map  
No Scale



City of Louisville

AREAS OF PD AMENDMENT #3

NOTE: SPECIAL PLANTING AREA 'G' SHALL BE IMPLEMENTED AT SUCH TIME THAT PAD 6, 7, 8 RTD DEVELOP THEIR INDIVIDUAL PROPERTIES  
TENANT ID SIGNAGE (3 TENANT)

**PHASE II PARKING CHART**

BUILDING	BUILDING SQFT	NO. OF SPACES	SPACES/1000 S.F.

**PHASE III PARKING CHART**

BUILDING	BUILDING SQFT	NO. OF SPACES	SPACES/1000 S.F.
RTD PARKING/STREET		400	NA

**SOUTHEASTERN PARCEL**

BUILDING	BUILDING S.F.	NUMBER OF SPACES	SPACES/1000
SUBTOTAL	106,000 S.F.	408	4.35/1000

AREA OF PD AMENDMENT #4

Town of Superior


Original Superior

Future Town Center  


The information contained in this drawing is intended for use only on this project. Unauthorized reproduction or use in other projects is not permitted. The Mulhern Group assumes no liability for construction information provided for use of the information contained herein. The Mulhern Group makes no representation or warranty of fitness. The Mulhern Group makes no representation or warranty of fitness for the performance of the design, construction or installation of the project. 

- DATE REVISION
- REVISED 12-1-99
  - REVISED 01-14-00
  - REVISED 3-4-00
  - REVISED 8-28-00
  - REVISED 2-1-01
  - REVISED 3-20-01
  - REVISED 4-5-01
  - REVISED 11-14-01
  - REVISED 6-28-02
  - REVISED SEPT 19, 2002


PROJECT NUMBER: 97045  
DRAWN BY: GD/DD/RW  
CHECKED BY: DD/MCM  
DESCRIPTION: SITE PLAN

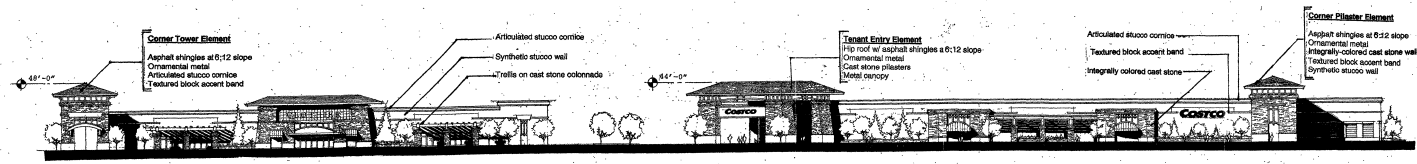


**1. EAST ELEVATION**  
FRONT OF MAJORS 1 & 2  
SCALE: 1/32" = 1'-0"

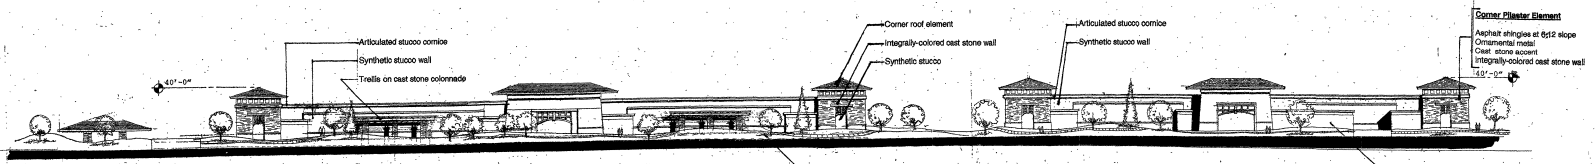


**2. WEST ELEVATION**  
REAR OF MAJORS 1 & 2 FACING 78<sup>TH</sup> ST.  
SCALE: 1/32" = 1'-0"

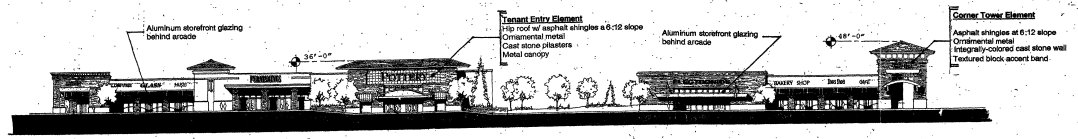


**3. EAST ELEVATION**  
FRONT OF RETAILERS  
SCALE: 1/32" = 1'-0"

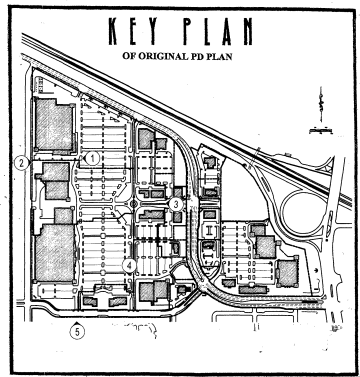

NOTE: KEY PLAN "UNCHANGED" TO COORDINATE WITH REPRESENTATIVE ARCHITECTURE AS SUBMITTED WITH PREVIOUSLY APPROVED PD.

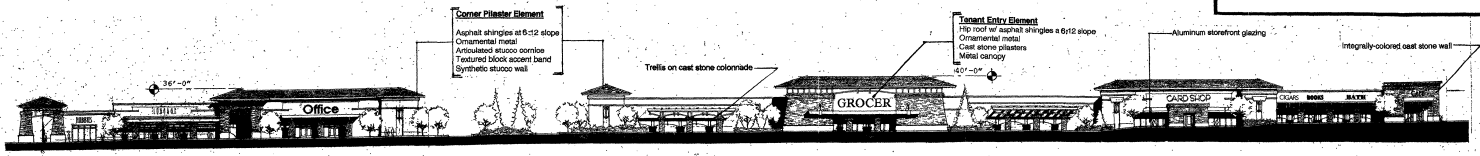

**4. NORTH ELEVATION**  
FRONT OF MAJORS  
SCALE: 1/32" = 1'-0"

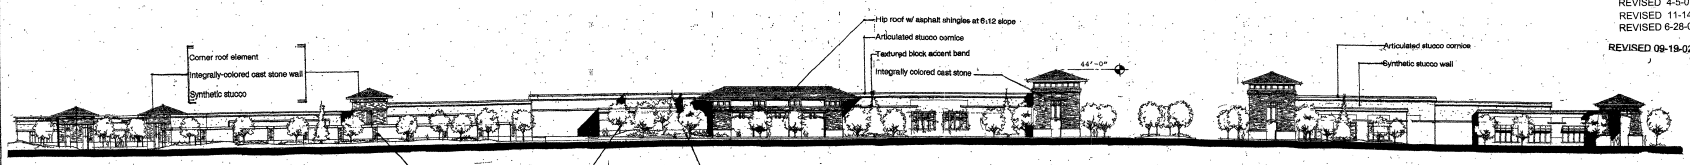

**5. SOUTH ELEVATION**  
REAR OF MAJORS FACING SYCAMORE ST.  
SCALE: 1/32" = 1'-0"

REVISED 12-1-99  
REVISED 01-14-00  
REVISED 3-1-00

DATE	REVISION
2.20.98	PD SUBMISSION
3.9.98	PLAN REVISION
3.25.98	PLAN REVISION
11.4.98	PLAN REVISION
11-14-01	REVISED 6-28-02
1.28.98	PLAN REVISION
5.18.98	PLAN REVISION
09-18-02	REVISED 09-18-02
1.26.99	PLAN REVISION
5.21.99	PLAN REVISION
REVISED	01-14-00


DATE	REVISION
07-04-00	PROJECT NUMBER: 87045
	DRAWN BY: DD/GD
	CHECKED BY: DD
	DESCRIPTION: ELEVATIONS



REFERENCE

**SUPERIOR MARKETPLACE**  
**PD AMENDMENT #4**  
**SUPERIOR, COLORADO**

The information contained in this drawing file is intended for use only on the project. Unauthorised reproduction or use in other projects is not permitted. The Mulhern Group assumes no liability for unauthorised reproduction, changes to, or use of the information contained herein. The information contained herein is provided on an "AS IS" basis. The Mulhern Group disclaims all warranties and makes no representation or warranty in the drawing file one to the performance of the design, including all implied warranties of fitness. The Mulhern Group assumes no obligation or liability for damages, including but not limited to, consequential damages arising out of or in connection with the use or performance of this drawing file and its delivery media.

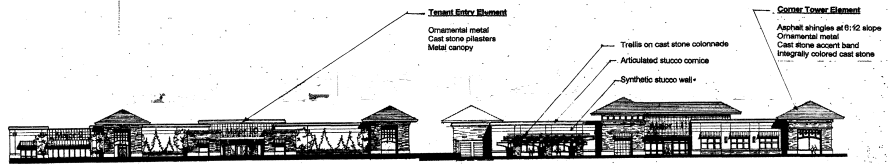

**6. WEST ELEVATION**  
MAJORS 9, 10 & 11  
SCALE: 1/32" = 1'-0"



**7. EAST ELEVATION**  
MAJORS 9, 10 & 11  
SCALE: 1/32" = 1'-0"



**8. NORTH ELEVATION**  
MAJOR 9  
SCALE: 1/32" = 1'-0"



**10. NORTH ELEVATION**  
MARSHALL ROAD SHOPS  
SCALE: 1/32" = 1'-0"



**17. SOUTH ELEVATION**  
MARSHALL ROAD SHOPS  
SCALE: 1/32" = 1'-0"




**9. SOUTH ELEVATION**  
MAJORS 9, 10 & 11  
SCALE: 1/32" = 1'-0"




**15. WEST/EAST ELEVATIONS**  
MARSHALL ROAD SHOPS B2  
SCALE: 1/32" = 1'-0"




**16. WEST/EAST ELEVATIONS**  
MARSHALL ROAD SHOPS B1  
SCALE: 1/32" = 1'-0"

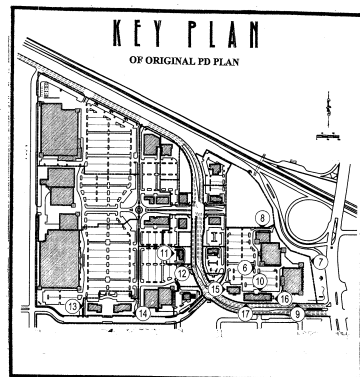


NOTE: KEY PLAN "UNCHANGED" TO COORDINATE WITH REPRESENTATIVE ARCHITECTURE AS SUBMITTED WITH PREVIOUSLY APPROVED PD.

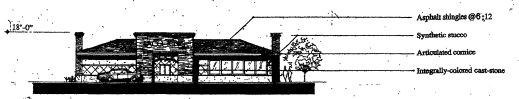


**11. SOUTH ELEVATION**  
TYPICAL PAD BUILDING  
SCALE: 1/16" = 1'-0"

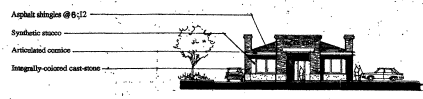

**12. EAST ELEVATION**  
TYPICAL PAD BUILDING  
SCALE: 1/16" = 1'-0"

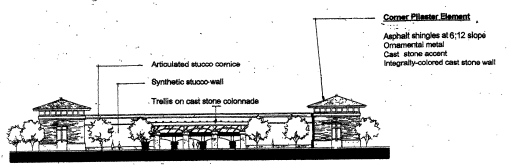

**13. WEST ELEVATION** (Final façade elevations subject to Town approval at FDP stage)  
FIFTH AVENUE PROMENADE  
SCALE: 1/32" = 1'-0"

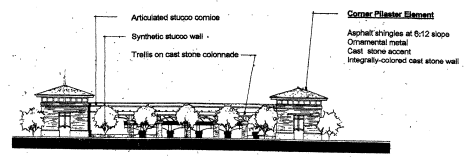

**14. EAST ELEVATION** (Final façade elevations subject to Town approval at FDP stage)  
FIFTH AVENUE PROMENADE  
SCALE: 1/32" = 1'-0"

REVISED 12-1-99  
REVISED 01-14-00  
REVISED 3-1-00  
REVISED 3-20-01  
REVISED 4-5-01  
REVISED 11-14-01  
REVISED 6-28-02  
REVISED 09-19-02

SUPERIOR MARKETPLACE  
PD AMENDMENT # 4  
SUPERIOR, COLORADO

The information contained in this drawing file is intended for use only on the project. Unintentional reproduction or use in other projects is not permitted. The Mulhern Group Ltd. assumes no liability for unauthorized reproduction, changes to or use of the information contained herein. The information provided herein is provided as a service to our clients and is not intended to constitute a contract. Mulhern Group Ltd. assumes no obligation or liability for damages, including but not limited to, consequential damages arising out of or in connection with the use or performance of this drawing file and its delivery media.

DATE	REVISION
5.14.98	PD SUBMITTAL
6.1.98	REVISION
1.28.99	REVISION
5.21.99	REVISION
8.23.99	PLAN REVISION
10.01.99	PLAN REVISION
11.4.99	REVISION
REVISED 2-1-01	
REVISED 01-14-00	
PROJECT NUMBER:	97044
DRAWN BY:	DD
CHECKED BY:	DD
DESCRIPTION:	ELEVATIONS

# SUPERIOR MARKETPLACE

PLANNED DEVELOPMENT/ZONE DISTRICT SITE PLAN SUBMITTAL  
NEW PLAN EXCEL REALTY TRUST, INC.  
A PORTION OF THE SE 1/4 OF SECTION 13 AND THE N 1/2  
OF THE NE 1/4 OF SECTION 24, T15R20W OF THE 6TH P.M.

THE HOLLAND GROUP, LTD.  
AMENDMENT # 4

## SUBMITTAL DESIGN GUIDELINES

### A. NARRATIVE

The proposed Superior Marketplace seeks to create a major commercial development for the Town of Superior. Elcor, LLC, intends to capitalize on the site's unique footage on U.S. 36 and McCaslin Road, good access, adjacency to Original Superior, strong regional demographics and existing demand. While it is the intent of the center to provide a focal point for the community it is also the intent that this center will provide a synergy which will attract shoppers from up to seven miles away. Thereby bringing in substantial tax revenue for the Town.

The proposed site, while offering great opportunities, also poses substantial challenges. The final design must tie in well with Original Superior, with respect to both planning and architecture, while at the same time creating buffers which protect the single family core. The new circulation system must provide for good access to the proposed Town Center mixed use development while also providing connectivity to Original Superior and newly proposed developments. At the same time, we must relocate a state highway, meet spacing requirements for signals along McCaslin and provide for an expanded interchange and Park 'n Ride facility.

We have sought to do this in the following manner:

### B. CIRCULATION ELEMENTS

Circulation elements have become major factors in the determination of the final site plan. Key factors are the following:

- Relocation of Marshall Road.** Connecting McCaslin (near Maple) to the existing Marshall Road ROW west of what would be Fourth Avenue.
- Location of Marshall Road just north of existing Maple.** Alternatively to No. 1 above, allowing existing Maple to act as a frontage road for existing residential lots facing north on Maple.
- Provision of Sycamore Street from Third to 7th.** Allows for direct access to Marshall Road and ultimately, McCaslin, for SURA's southern 9 1/4-acre of the mixed use development and the proposed Sycamore development. This access further protects Original Superior by providing quick, efficient travel to McCaslin thereby discouraging use of existing roadway.
- Connection of future Fifth Avenue directly into the proposed commercial development.** Provides direct connection into the heart of the center for existing development to the east and future developments to the south of the SURA District, while not encouraging use by those not living in Original Superior.

### C. BUFFERS

Three major buffers have been incorporated in the proposed plan:

- Maple Street.** Per the original Advisory Committee's recommendation, the proposal has incorporated a 30' landscaped buffer paralleling Maple Street and the relocated Marshall Road. Just north of the two existing residences on Maple, this landscaped buffer increases to 42' at the east and 57' at the western edge. This buffer will be bermed and well landscaped to protect the residential character of Maple Street as it develops. It will be pierced at strategic locations to provide pedestrian and bicycle connections from Original Superior to the commercial development.
- 2.1st-acre from Coal Creek to Maple, 4th to 7th.** This area is planned as a transitional zoning buffer between the residential planned south of Coal Creek (per the same plan) and the larger commercial district. It is proposed as a commercial or government center in accord with current zoning. It will tie to the major commercial development via the 5th Avenue Promenade. To minimize traffic impacts on Coal Creek curb cuts for the development should be predominantly located on Sycamore Street thereby discouraging use of Original Superior street system.
- 3. Rear of commercial development.** To minimize adverse impacts by the rear of the commercial development we have sought to create service courts versus the typical "wraparound" service drives. In most cases, backs of buildings parallel the street being separated by a landscaped area with a minimum depth of 25' from the property line combining with an additional setback from the curb of 18' to create a total setback of 40-43'. Acting with the streets, a strong buffer is created for existing and future residential developments. Consistent with this, retailers (pods) along Marshall shall generally be within 20' of the ROW to reinforce the "urban" nature of the plan.

### D. PLANNING OF THE COMMERCIAL DEVELOPMENT

The commercial development has been broken into two major components.

West of Marshall Road will be a commercial development of approximately 56 acres. The size of this development is such that it should provide for an interesting mix of tenants, including general merchandise, soft goods, electronics, party goods, groceries, office supplies and restaurants.

The Marketplace provides for a large mix of tenants oriented east and north with various outbuildings articulating entries at Marshall Road.

The Master Plan features two major tree-lined drives which meet at a landscaped roundabout at the center of the development. Deep landscaped setbacks have also been provided along Marshall Road to allow for gracious landscaped detention areas along the major thoroughfare. The southern portion of the major north-south drive has been widened and landscaped to create a major promenade in order to link with future development to the south.

Major buildings step in and out to create visual interest and break up large masses while drives and pedestrian walks meander to address this stepping. This meandering slows traffic while creating interesting walks similar to the development at 92nd and Sheridan.

Parking is presently provided at a minimum of 4.8 sq/1000 s.f. In most cases we are shooting for ratios of 5 sq/1000 s.f. of retail and 10 sq/1000 s.f. of restaurants to assure adequate parking for all. Landscaped islands are provided every 20 spaces per Superior guidelines and linear landscaped medians are provided at strategic rows to further break up larger parking areas.

### E. EASTERN COMMERCIAL DEVELOPMENT/TRANSPORTATION HUB

The eastern area is comprised of approximately 21.77 acres. It has been planned to provide an entertainment complex in concert with restaurants and an expanded RTD Park 'n Ride.

Circulation is simple with a major tree-lined north-south drive at the west end of the parking area accessed at the Sycamore intersection. This drive is designed to provide connections to parking for the Park 'n Ride. A second east-west boulevard off the center's main entrance provides direct access to some shops, a drop-off for the Park 'n Ride and the Southeast retail complex.

Major buildings step in and out to create visual interest and break up large masses while drives and pedestrian walks meander to address this stepping. This meandering slows traffic while creating interesting walks similar to the development at 92nd and Sheridan.

### F. ARCHITECTURAL THEME

The major buildings and shops buildings will be of an architecturally consistent theme incorporating similar materials. All other buildings shall be controlled per the proposed architectural guidelines and the CC&R's as submitted to the town.

In development of the theme it shall be our effort to create a look which is unique and compatible with the town of Superior. The magnitude of the Marketplace and the fact that it is the only major commercial development in the town will help to assure that the image of the town is conveyed through the Marketplace. This may be furthered by the introduction of this design vocabulary to other commercial and residential developments proposed within the town in the future.

### ARCHITECTURAL GUIDELINES

#### A. INTENT

The Superior Marketplace is intended to be a comprehensively designed retail, entertainment and commercial development. When completed, it will bring together a wide array of tenants offering an extensive range of goods, entertainment opportunities and a smaller scale commerce or government development to the Town of Superior. This is to be in an architecturally unified, well-landscaped complex which provides for a safe, pleasant, and interesting shopping environment for the citizens and guests who visit this exciting mixed use development.

To that end, plans and conceptual elevations have been developed and are attached to this PD. Should there be necessary future design deviations of the major buildings or as one seeks to determine the appropriate design of the planned pad buildings, the following guidelines are set forth.

The architectural "theme" for the Superior Marketplace is best described as a "Craftsman Image," with a distinctive combination of materials and forms to create the theme. Through Superior, one is struck by the use of Colorado native sandstone on bridges and on public buildings, as well as generous use in the Rock Creek subdivision. This abundance legitimizes this material as "indigenous" to Superior. Because of this, the proposed architecture has been provided with a generous amount of cast stone to augment and perpetuate this material as the image presented by Superior.

The use of integrally-colored cast stone, stucco and ornamental metal combine in Craftsman-style forms: towers with hipped roofs, battered walls and pilasters to support ornamental metal and colonnades with arching metal accents to create arcades that support metal canopies. Roofs and canopies provide generous overhangs to emphasize their horizontal nature - a Craftsman aesthetic. Ornamental iron accents this and creates another layer of design unifying the different forms of the composition. Towers combined with hip roofs break up the parapet lines of the retailers, helping to create an intriguing roofscape. The arrangement of towers, colonnades and major tenant entries creates a composition of elements that establishes a hierarchy for the center, while reinforcing the mass of the development to a more human scale. The arrangement of elements seeks to differentiate tenants and will be employed in such a fashion so as to accentuate this. Freestanding towers, pilaster towers, and parapet towers articulate building corners and different tenants. Arcades define entries, retail storefronts and help to break up long building facades.

Although there is not a set "formula" for which users employ which specific elements, the elevation convey an overall sense of variety in the responding and relative spacing of the elements. Parapet lines between users may stagger to convey a difference in floor levels; however, this stagger should be distanced by use of a tower, roof, or pilaster element.

#### B. THE MAJOR BUILDING ENVELOPE

The Major Building envelope shall be composed of accented stucco with details and color to establish a base, middle and top. It shall be embodied by cast stone at the entries, tower elements and trellis elements, if included in the composition, and at sidewalk planters. The building design has been varied to incorporate variations of the craftsman theme to provide additional interest and richness in the overall composition. Said design shall be complementary to the overall theme. Attention to sequencing of massing elements to reinforce an overall hierarchy of elements will be maintained. A 360° architecture will be employed by pulling towers and trellises with stucco patterning, ground face block banding, articulated corners and accent detailing around to the sides and rears of the buildings.

Materials incorporated shall be as follows:

- 1. Fronts:**
  - a. Cast Flagstone:** Stone to cover not less than 30% of the overall area of all users combined. The front face of columns faced in stone shall be considered a part of the facade, as would attached stone-faced planters. Stone may be intermittent between users, so long as an average of 30% is maintained on each major massing (i.e., Major 1 and Major 2, south of Major 2 to the southwest pedestrian plaza, from the southwest pedestrian plaza to 5th Avenue and from 5th east), unless approved otherwise by the town.
  - b. CMU:** Maximum wall area allowed shall not exceed 25%. CMU shall only be used to create bases or accent banding with split or ground face units (integrally colored or stained). Banding shall be utilized to differentiate between a frontage's base, middle and top. Differentiation shall occur on 75% of the buildings, minimum. Bands shall not exceed 16" in height, typical. Bands shall not exceed 1/4 of building height, maximum.
  - c. Stucco:** Approved colors and textures only. Stucco shall not exceed 75% of area averaged over entire center's frontages.

- d. Glazing:** All users shall incorporate not less than 25% of linear footage as glazed doors or windows. All window and door frames to be uniform in color and finish throughout center. (Color shall be bronze, burnished or a compatible "wood" color). Users are encouraged to increase amount of glazing in building frontages.
- Exception: Major 1, being 136,565 s.f. (a discount warehouse operation), and a major grocer of 55,000-75,000 s.f. shall be exempt from the "glazing" portion (1.4) of this provision although efforts by these users to meet these requirements is encouraged.

- 2. Sides:**
  - a. Cast flagstone:** To cover no less than 15% of overall wall area (including corners and attached planters) unless otherwise approved by Town.
  - b. CMU:** Maximum wall area shall not exceed 25%. Banding to occur at specifically designated portions. Banding shall be utilized to differentiate between a frontage's base, middle or top and shall not exceed 16" in height, typical. Differentiation shall occur on 75% of the buildings, minimum.
  - c. Stucco:** Approved colors and textures only.
- 3. Rears:**
  - a. Cast flagstone:** To cover no less than 15% of over all wall area exposed to public view (including columns and attached planters) unless otherwise approved by Town. See special notes for Sycamore Street elevations.
  - b. CMU:** Maximum wall area shall not exceed 25%. Banding to occur at specifically designated portions. Banding shall be utilized to differentiate between a frontage's base, middle or top and shall not exceed 16" in height, typical. Differentiation shall occur on 75% of the buildings, minimum.
  - c. Stucco:** Approved colors and textures only.
- 4. Roofs:**

All sloped roofs to conform to a 6:12 slope, typical and be covered with center standard roofing material (as determined by town planning review process). The use of hips, sheds and towers are encouraged to provide a varied roofscape. No more than 70% of any visually unbroken facade may include multiple tenants; shall be flat (straight) parapet unless interrupted by sloping (shed or hipped 6:12 slope) residential roof elements. When flat parapets do occur, they shall be capped by either an articulated cornice (center standard) or pre-finished metal coping cap of complementing color. Roofing mats, to be approved by Town at FDP stage.
- 5. Screening of rooftop units:**

All HVAC units throughout the SURA District shall be screened from view within Superior by a building parapet of equal height, or a screen wall of stucco to match design, detailing and the materials of the building or other appropriate screening. Determination of the appropriateness of the design as to its location shall be the sole discretion of the Town staff.
- 6. Wall Composition:**

In an effort to alleviate long uninterrupted facades, any wall face shall conform to the following restrictions.

Main Building Frontage (incorporating primary entry doors).

- a. No wall expanses shall extend over 75' linear feet without incorporating at least one architectural feature(s) of at least 24" in length total and at least one-third the building height. Architectural features shall include** either towers, entry elements, flagstone colonnades with trellis', pilaster towers, vision glass, or display windows. Attached planters at buildings shall not be designated as an architectural feature, however, the use of cast stone at the planter face may apply to a frontage's minimum stone requirements as it is in essence a projection of the building base. Attached planter boxes of cast stone shall be provided at a minimum of 25% of building frontage on at least one-half the users, averaged over the entire center.

Note: Glazing is included as an architectural feature to encourage tenants to incorporate glass. Windows, whether looking into the store or presenting display add substantially to a building's interest both during the day or night.

- b. Building Sides and Rears.** Architectural features as listed above shall occur in no less than 20% of the entire linear wall length while also meeting the 75' rule. Said articulation need not occur within a loading court area. However, wall area above the elevation of screen wall must display corner details and roof details as in accord with previously noted requirements.
- c. Diagonal Screen Walls Adjacent to Intersection of 70th and Sycamore.** Since these walls may include a majority of the shop's rear facades, as the outer wall face, they shall be distinguished by architectural elements that may include:
  - Metal trellis attachments
  - Cast stone pilasters
  - CMU accent band coping cap

Said elements shall encompass not less than 20% of the screen wall area applied to and the amount of cast stone shall meet the Sycamore Street Design Guidelines.

### C. BUILDING ENTRIES

The entry to each major user shall be highlighted and protected by a well-designed arcade vestibule, awning, or canopy. These elements shall be composed of not less than 50% cast flagstone, with the remaining being ornamental metalwork, canopy swaging elements, stucco sign band or flagstone tile. Said tenant entry should employ the integrally-colored cast stone and/or ornamental metal to contrast from the Major Building envelope. The scale or mass of any tenant entry should be proportional to the square footage of said user. Said determination of proportionality shall be at sole discretion of Town staff at FDP stage. No entry element shall exceed beyond 15' the building height over parapet line. Signage should be in proportion to the entry element to create a pleasing architectural composition.

### D. ORNAMENTAL IRONWORK

Where appropriate, ornamental ironwork, complimentary to that illustrated in the PD shall be introduced into the overall composition. A variety of designs will provide for additional architectural interest, as well as continuity, throughout the center. All styles of ironwork are shown on, or shall be compatible with the styles indicated on the building elevations sheets. No less than half (50%) of the primary building entries shall display ornamental ironwork. Said ironwork to envelope a minimum of 5% of these entry elements. (Tracking of percentage rules shall be by Architectural Review Committee established by Master Developer).

### E. PEDESTRIAN WALKS

The Superior Marketplace has been designed to provide a pedestrian-friendly environment. Therefore, special attention shall be given to all walking surfaces especially those in front of each retail user. Walks at major public areas, i.e., Plaza, Pedestrian Plaza at 2nd and Marshall, major entry drive shops, the 5th Avenue promenade, the Southwest Shops Plaza and any other special plazas, shall feature additional stucco and a minimum of 20% colored concrete. Also incorporated shall be an area of integrally colored concrete pavers, brick pavers or stamped concrete. Said area shall equate to a minimum of 5% of that area designated as special paving area. Street trees shall be placed adjacent a facade and planters shall be placed between building entries where grade changes occur and unbroken walk areas exceed a width of 20 feet. These trees shall be placed in tree grates or shrub beds. The locations may be adjusted, however, the number of trees shown on the PD at the sidewalk, shall not be reduced. Architectural paving shall be introduced at handicapped ramp areas. Pedestrian pole, walk-mounted lights, freestanding sidewalk benches and colonnades with trellises will work to finish the pedestrian nature of the building fronts. Lights and street furnishings are further described below.

- 1. Restrictions:**
  - a. Minimum** depth from curb to building at pads is 12'. Minimum depth from curb to building at major users and outlying shop buildings is 15', however, average depth at major users shall not be less than 20' including planters.
  - b. Minimum** number of trees at front facades. All building entry frontages shall include a minimum of one street tree per 60' of frontage on the average. Said trees may be located in tree grates, shrub beds, grass lawns or attached or detached planters.
  - c. Attached** planter boxes of cast stone shall be provided at a minimum of 25% of building frontage on at least one-half the users, averaged over the entire center.

REVISED 12-1-99  
REVISED 01-14-00  
REVISED 3-1-00  
REVISED 2-1-01  
REVISED 3-20-01

REVISED 4-5-01  
REVISED 11-14-01  
REVISED 08-28-02  
REVISED 09-19-02

SUPERIOR MARKETPLACE

NEW PLAN EXCEL REALTY TRUST, INC.

SHEET

5

THE HOLLAND GROUP, LTD.

Page 5 of 18

# SUPERIOR MARKETPLACE

PLANNED DEVELOPMENT/ZONE DISTRICT SITE PLAN SUBMITTAL  
NEW PLAN EXCEL REALTY TRUST, INC.




THE MULBERRY GROUP, LTD.  
**AMENDMENT # 4**

A PORTION OF THE SE 1/4 OF SECTION 13 AND THE N 1/2 OF THE NE 1/4 OF SECTION 24, T15, R70W OF THE 6TH P.M.

## F. SITE FURNISHINGS

Major site furnishings include benches, waste receptacles, bicycle racks, and tree grates. In general, visual continuity of these elements is desired throughout the project. The color, in addition to design, will create continuity on the site. All components of outdoor site furniture should be low maintenance and durable. Said fixtures shall be located at all major pedestrian plazas and other areas deemed appropriate in the F.D.P. phase.

- Tree Grate:** Ironsmith Olympian or approved equal
- Waste Receptacle:** Victor Stanley T5e T Series or 32 gallon steel receptacle with standard spun steel tapered lid or approved equal
- Radius Bench with Back:** Gametime The Ultrum Collection or approved equal
- Backless Bench:** Gametime The Ultrum Collection or approved equal
- Bicycle Racks:** Cycloope Super 2175 or approved equal.

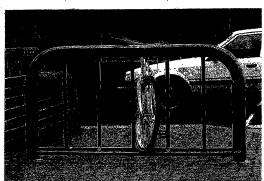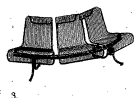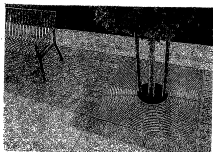

## G. PAD BUILDINGS

These buildings, by their nature, are in high visibility locations. Given this, 360 degree architectural treatments shall be employed and great sensitivity must be given to the screening of service areas and utility entries. The architecture of these buildings shall be compatible to that of the center in mass, material, color and details. All facades of these pad buildings shall be a minimum of 20% integrally-colored cast stone. CMU (ground-faced or split-faced), may be used as a base or accent band only. Bands shall not exceed 16" in height, typical. Bases shall not exceed 1/4 of building height, maximum. Roofing materials must be compatible with the overall design and color intent of the center. These shall be determined by planning staff. Entry areas shall be highlighted by unique architectural treatments where appropriate. The introduction of display windows for users backing up to Marshall Road and McCaillin Boulevard shall be encouraged, and 20% of linear footage on these roads shall be vision or display windows at least 10' above finished floor. Spandrel glazing shall not be utilized in these calculations. (Note: Spandrel glass may only be used to expand a field of vision glass. It shall be limited to 25% of that field, maximum).

Ornamental ironwork shall be worked into arcades, vestibules and/or canopies. Canvas awnings may be incorporated, however, they shall not be backlit. The sidewalk treatment shall be restricted as previously noted in "K. Pedestrian Walks" and landscaping of pad sites shall meet the intent of the original quality of the design with respect to size and spacing of materials including ground cover and mulch. For purposes of these guidelines, the proposed theatre (and attached) buildings shall be designated as "pads."

Pad buildings may incorporate a drive-thru with the exception of those included in the entry restaurant/shop complex in the conceptual plan. (Pads 3-6 and the adjoining shops buildings.)


## H. LIGHT STANDARDS

All light standards, be they parking, pedestrian pole or wall-mounted fixtures, shall be those shown in these documents.

### Lighting Fixtures

Lighting fixtures incorporated within the SURA District shall be as follows:

- Street Lighting:** Street lighting fixtures shall be similar, as shown in illustration #1" or an approved equal. Said fixtures shall be green to match McCaillin standards and shall not exceed 12 feet in height. Fixtures shall exhibit cut-off capabilities to minimize off-site spillage.
- Parking Lot Lighting:** Parking lot lights shall be the same as the street lights shown in illustration #1. Said lights shall not exceed a height of 5'5" including the concrete base. Fixtures shall exhibit cut-off capabilities to minimize off-site illumination spillage.
- Ornamental Lights at Sidewalks and Pedestrian Plazas:** Ornamental lights at sidewalks and pedestrian plazas shall include double-pole mounted, single-pole mounted and wall-mounted fixtures designed to match those ornamental fixtures at the bridge on McCaillin. See illustration #2.
- Security Lighting:** Security lighting may be wall packs and of color not in the color section. Said lighting shall be allowed as loading areas only. Said lights shall not project above dock screen wall.

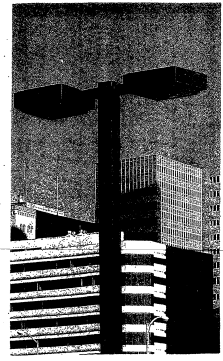

## I. 5<sup>th</sup> AVENUE PROMENADE

NO LONGER VALID

## J. COLOR SCHEME

As all buildings are to be architecturally compatible, variations in sympathetic colors will afford interest to the overall center and help provide a human scale for the center. The range of colors shall be as follows:

- Integrally-colored cast stone:** Although a range of hues is anticipated, all units to be in the red/brown/tuff range to be sympathetic to stone utilized. Applied in a "masonry ledge" pattern across composition, colors should not be segregated in order to create a uniformity across the site.
- Stucco:** Smooth to medium textures will be utilized in a range of light tan to medium brown-to contrast yet complement the rough texture and deep colors of the cast flagstone.
- CMU (split face or ground face):** Will be stained or integrally colored at new buildings to avoid a "painted" look. This stain shall be complementary to the colors of the stone and stucco.
- Ornamental Ironwork:** These colors shall bring life to the color compositions. They should give a clean, crisp feeling. Colors may be bright white, off white, or hazel/forest green, and deemed appropriate (at Town staff's discretion) to the architectural composition of the building and pavilions overall.
- Glazing:** Glazing shall be clear only.
- Glazing System:** The Glazing System shall be medium bronze anodized aluminum, or green (center standard) "Kynar" finished or bronze duranodic.
- Architectural Roofing:** Shall be uniform across site, to be determined by planning staff resolution.
- Light Standards:** Lights and light standards in parking areas, major drives and pedestrian walkways shall be green to match those fixtures at McCaillin. Lights and light standards at loading bays may be bronze anodized or of a color to match the adjacent wall surface so that they disappear.
- Pre-cast concrete:** Pre-cast concrete shall be light tan/tuff.

- Awnings:** Awning color may vary as long as it is appropriate to the building composition. However, awnings may not be orange or black.
- Accent tiles:** Accent tiles of green, black, tan or white may be introduced if successfully integrated into the architectural design of the building and shopping center.
- Corporate Colors:** Corporate colors may be exemplified in signage, awning and logos, however awning may not be orange or black.

## K. ELEVATIONS OF COMMERCIAL STRUCTURES FACING SOUTH ONTO SYCAMORE STREET.

In any major retail development there exists a rear of buildings where loading service and storage occur. Sycamore Street will be an important entry conduit for the Sagamore development and the SURA District community panels. Fifth Street will provide an important access point to the commercial development from Original Superior, thus additional care must be taken in the design of this frontage.

These guidelines shall apply to either the rear of majors without "community shops" planned in front of them.

- Cast flagstone shall cover no less than 15% of overall wall area in public view (areas within loading courts are exempt).
- The architecture at the corners of buildings adjacent to 5<sup>th</sup> Street shall make an "entry statement" through the use of pilaster tower elements.
- The intersection of 5<sup>th</sup> and Sycamore shall be made pedestrian friendly through the use of concrete crosswalks and small plazas at the northern corner.
- Loading areas shall be clustered as loading courts wherever possible. 13'-6" (minimum) screen walls shall be provided at all dock areas directly adjacent to the ROW.
- The rear of these buildings shall incorporate sloped roof elements which comprise a minimum of 20% of the length of the Sycamore facade.
- The architecture detailing of these buildings shall be in keeping with the front of the buildings however at a limited scale. Therefore wrapping the building architecture.
- Landscaping. Landscaping shall be taken to the building wherever possible. Said landscaping shall include a variety of meandering forms planned with a combination of deciduous and coniferous trees.
- Glass. Although glazing is typically not appropriate to the rear of a building its use is encouraged. To that end, if a screen introduces glass along this frontage in the form of a vision window, or display window said tenant shall be allowed sensitively applied signage at this frontage. Said sign area shall equal one square foot per square foot of glass area. However, said sign shall not exceed 18" in height nor 50 s.f. total. All signage shall be individually pan channel letters. However, they may not be illuminated.

**9. Sycamore Street Location.** The preliminary PD shows a location of Sycamore Street which the Authority, the Town and the Redeveloper agree may need to be relocated to accommodate the desire of the Town and the Authority to permit construction of retail on the Property on the north side of, and facing, Sycamore Street. If the buildings along on the Property on the north side of, and facing, Sycamore Street have been relocated up to ten (10) feet north to accommodate such retail shops, and if requested by Elcor, the Town and the Authority agree to relocate the street up to an equivalent of ten (10) feet south of the original planned location so as to accommodate the possibility of future construction of commercial buildings facing Sycamore Street. Redeveloper shall design and locate buildings to be constructed by Redeveloper on the Property so as to permit possible future construction by Redeveloper of commercial buildings facing Sycamore Street; provided, however, Redeveloper shall have no obligation to construct such buildings at any time; and provided further, that no event shall Redeveloper be required to locate any building more than ten (10) feet north of the location depicted.

## 10. SMALL SCALE RETAIL SHOPS

Since this revised PD incorporates retail shop buildings that are conceptually different from the rear of Major tenants conceived in the initial submittal, the following will apply to said retail buildings:

- All elevations shall employ a minimum of 20% cast stone, primarily used in entry elements, sign areas and corner pilasters, typ.
- Sloped roofing elements shall be restricted, to create a smaller sense of scale.
- Maximum shop building height = 28' A.F.F.
- Glazing shall cover no less than 50% of the north and south facades.

## L. LOADING DOCKS.

Loading dock areas must be sensitively handled throughout the project. To that end, the following shall apply:

- Dock areas where exposed to public view, shall be screened with a masonry wall that is a minimum of 13'-6" above the grade of dock and a minimum length of 55' to effectively screen a tractor trailer. Said wall shall meet architectural requirements listed in this document.
- If loading docks are within 150' of residentially zoned property and loading occurs between the hours of 10 p.m. and 6 a.m., said dock areas shall be also enclosed by a roof structure.
- Lights incorporated at dock areas and at the rear of buildings shall be "cut off" fixtures not allowing casting of light onto the ground plane beyond the property line at adjacent ROWs.
- Noise at loading docks shall not exceed the following decibels at property lines adjacent to a residentially zoned property:  
\_Sycamore\_ 50 dba both day and night.\*  
76<sup>th</sup> Avenue 50 dba from 7p.m. to 7a.m.  
60 dba from 7a.m. to 7p.m.

These levels are to be enforced as per the Colorado Revised Statutes Volume 11A, 1989 Replacement Volume, Government IIA, Article 12, Noise Abatement.  
\*55 dba allowed both day and night if no residential located south of Sycamore St.

## M. SPECIAL COVENANTS.

- Special covenants shall be introduced into the development's C.C.&R.'s to control the following:
  - At auto uses special covenants requiring provision and maintenance of trash receptacles and steam cleaning of parking areas on a regular basis.
  - Restrictions limiting storage of vehicles to 36 hours.

## N. PROJECT TITLE.

Upon completion of the approval process the developer may change the name of project. The original name Superior Towne Center shall be reserved for future town projects. Currently, the name of the center is Superior Marketplace.

The developer shall endeavor to have RTD identify the Park 'n Ride area as the Superior Park 'n Ride deleting the reference to Louisville as no portion of the Park 'n Ride is in Louisville.

REVISED 12-19-98  
REVISED 01-14-00  
REVISED 3-1-00  
REVISED 2-1-01  
REVISED 3-20-01  
REVISED 4-6-01  
REVISED 11-14-01  
REVISED 8-28-02  
REVISED 09-19-02

SUPERIOR MARKETPLACE	
NEW PLAN EXCEL REALTY TRUST, INC.	SHEET
THE MULBERRY GROUP, LTD.	

6

Page 4 of 18



# SUPERIOR MARKETPLACE

PLANNED DEVELOPMENT/ZONE DISTRICT SITE PLAN SUBMITTAL  
NEW PLAN EXCEL REALTY TRUST, INC.

A PORTION OF THE SE 1/4 OF SECTION 13 AND THE N 1/2 OF SECTION 24, T1S. R70W OF THE 6TH P.M.  
AMENDMENT #4

THE HOLBORN GROUP, LTD.

### O. BICYCLE CIRCULATION.

Bicycle circulation is an important part of the SURA District. The following restrictions shall apply:

- Bikes lanes at Marshall Road:** Seven-foot wide bike lanes shall be incorporated at Marshall Road from the Sycamore intersection to the 76<sup>th</sup> Street intersection. In order to assure a more permanent marking of these lanes they shall be striped and identified utilizing thermoplastic material versus paint.
- Combination bike/pedestrian paths at Marshall Road:** Eight-foot wide (off-street) paths shall be located on both sides of Marshall Road from McCaslin to the major entry of the commercial development. Said paths shall be striped and noted with 4' for bicycles and 4' for pedestrians.
- Bicycle racks:** Racks shall be incorporated throughout the development. Said racks shall be introduced in all FDP submittals at locations deemed appropriate by staff.

### P. UNOBSTRUCTED OPEN SPACE.

North of a line equating to the southern ROW line of Sycamore Street, within the SURA District, unobstructed open space shall equate to a minimum of 25% of the total site area. This shall include ROWs within the area defined.

Unobstructed open space shall be composed of the following:

- Islands, medians, etc., when located within a parking area when equating to 400 s.f. or more.
- Landscaped areas at the site perimeter, within the site, within ROWs and within walk areas.
- Walks within a landscaped area.
- Pedestrian plazas when greater than 5,000 s.f.

### Q. LANDSCAPED AREAS WITHIN PARKING LOTS.

Landscaped areas within a rectangle formed by the perimeter of a parking area shall constitute a minimum of 5% of the parking area.

### R. OTHER OPEN SPACE.

In determining overall site coverage there shall be a category noted as other open space. Said space shall be that area not classified as building footprint, paved areas (road, drives, loading areas, parking lots), or unobstructed open space. Said space will include walks when not within landscaped areas, plaza less than 5,000 s.f., parking lot islands less than 400 s.f. and other such spaces.

The landscaped berm at the COSTCO fueling station shall be bermed and landscaped in such a manner so that the solid portions of the fueling pumps are screened from view from Marshall Road and US 36.

### S. LANDSCAPING SUBSTITUTIONS / COMPONENTS

- Shrub/wood substitution at islands.**  
The restriction requiring one tree and three shrubs for each 20 parking spaces shall be amended as follows. In lieu of shrubs a grassed, irrigated berm may be provided at islands and medians.
- Tree/Shrub Substitutions.**  
In determination of the number of trees and shrubs required, one tree may be substituted for ten shrubs required or vice versa.
- Final landscaping design** shall include components to provide a liberal use of wildflowers and boulders to create a quality landscape effect.

### T. PEDESTRIAN CIRCULATION WITHIN PARKING AREAS.

Pedestrian walkways shall be incorporated at key locations within parking areas. Said walks shall continue across drives as concrete, thereby, providing a change in color and texture to alert drivers of the pedestrian crossing. These will serve as traffic calming devices.

### U. ARCHITECTURAL REVIEW COMMITTEE (ARC) BY MASTER DEVELOPER.

The Master Developer shall staff and maintain an ARC for the duration of the physical development of the center. The ARC shall be established for purposes of reviewing all FDP applications and any FDP amendment applications for compliance with these Design Guidelines. The ARC shall review all FDP applications prior to the applicant submitting such applications to the Town. The ARC shall forward a letter of compliance to the Town regarding each application. The Town reserves the right to determine final compliance with these Design Guidelines.

### V. VIEWS TO AND FROM THE DEVELOPMENT.

Views west to the foothills. The SURA District development, being predominantly one-story retail, will help to maintain the present views to the Flatirons. This will be enhanced by the grading plan which will step down at 76<sup>th</sup> and then provide a gentle grade of approximately 3% to McCaslin.

One will continue to see the Flatirons from many locations within the district, however, these views will diminish as one approaches buildings from east to west.

- Height:** To further assure views to the Flatirons will be preserved, heights of the buildings shall be limited as follows:

	Base parapet	Accessory lower & entry elements
Retail buildings	35'	45'
Office/Government buildings	35'	50'
Major towers		50'
- Views north along McCaslin:** There will be some views to the eastern edge of the SURA District development as one proceeds north on McCaslin.  
The parapet of this roof shall be equal in the height of all HVAC units and these units shall be laid out in a neat linear fashion. The success of this requirement is seen in the view to the existing Mann Theater building where all units are screened with a parapet versus Eagle Hardware where units are screened individually and Home Depot where units project above the parapet heights.
- HVAC units will also be required to be screened in such a manner so as not to be viewed from U.S. 36 at Davidson Mesa.

### W. BUILDING SETBACKS.

- Setback**
- Adjacent to Marshall Road, McCaslin at U.S. 36 ROW, 20' from ROW
  - Adjacent to 76<sup>th</sup> Street / Sycamore Street, 4<sup>th</sup>, 5<sup>th</sup> Aves 25' from ROW
  - North, east and south of outparcel along 76<sup>th</sup> Street, 30' from prop. line.
  - Internal lot lines.

### DESIGN AND PLANNING CRITERIA FOR SUPERIOR MARKETPLACE

#### A. PERMITTED USES

- Retail Commercial** as defined herein: Those retail and service businesses which provide a full range of merchandise and services. Such businesses shall consist of the following:
  - Discount stores, membership merchandising stores, catalogue stores and specialty warehouse stores.
  - Entertainment facilities, including, but not limited to movie theaters, bowling alleys and skating rinks.
  - Recreation facilities, including, but not limited to swimming, golf, tennis, health and court sports facilities.
  - Supermarkets and specialty food stores.
  - Specialty retail and personal service businesses, including, but not limited to, health spas, specialty clothing and clothing accessory shops, sporting goods stores, card and gift shops, art and art supply stores, culinary supply stores, toy stores, pet stores, bookstores, hardware stores, electronic equipment stores, furniture, appliance and home furnishings stores, printing shops, banks with drive-up teller, savings and loans and finance companies.
  - Free standing, sit-down restaurants. Such restaurants shall be encouraged to have screened, outdoor dining areas. Restaurants may have drive-thru facilities, if said buildings are not part of the entry restaurant/shop complex. In the conceptual plan this area includes pads 3-5 and the two adjoining shop buildings.
  - Cell phone relays such that they are inconspicuously placed from the public view, or incorporated as an integral design feature.
- Administrative and professional offices** as defined herein:
  - General Offices, for example:
    - Administrative and executive offices.
    - Consulting service offices (business and professional).
    - Design professions (architect, planner, etc.)
    - Financial institutions (including drive-through facilities, freestanding ATMs).
    - Medical, dental and veterinary offices.
    - Insurance and investment offices, etc.
  - Public or private meeting hall.
  - Nursery school, day care center.
  - Appurtenant retail uses including restaurants, sandwich shops and cafeterias shall be permitted within principal use buildings, provided that the entrance to any such restaurant, sandwich shop or cafeteria shall be from inside the principal use building, and provided that no more than fifteen (15%) percent of said principal use building shall be devoted to such usage. Parking structures shall be permitted as accessory uses.
  - Government centers.
- Other:**
  - Parking associated with all uses (to be provided per ADA standards).
  - Preschool nurseries and child care centers.
  - Parks and recreational open space.
  - Accessory buildings and uses.
  - Other uses not specifically listed herein require a use permit.
  - Public facilities and utilities.
  - Commercial mobile radio service facilities - building-mounted antennas only; equipment shelters must be fully screened.

- Auxiliary uses:**
  - Auxiliary uses for Major 1 to include fuel pumps and tire center shall be an allowed use.
- Use by Special Review:**
  - Auto specialty stores (i.e., tire, muffler, parts, glass).
  - Lofts or other residential units above commercial shops not to exceed 12 units per gross acre.
- Use by Administrative Permit:**
  - Portable kiosks and push cart vendors.
  - Street entertainers.

### B. EXCLUDED USES

- Those uses and activities which are specifically prohibited are as follows:
  - Adult bookstores, adult entertainment and other adult-oriented activities.
  - Outdoor storage, except for garden and nursery supplies and other, similar seasonal merchandise.
  - Rental agencies for heavy equipment.
  - Mini-storage facilities.
  - Warehousing and light industrial uses.
  - Car wash facilities of any kind.
  - Outdoor (non-screened) storage of vehicles (for service) for a period exceeding 36 hours.
  - Auto body repair stores.
  - Multi-family residential other than that described in section A.5.b. Use by special review.
  - Pawn and second hand shop.

### SURA DISTRICT MAINTENANCE OUTLINE

#### A. DEVELOPER RESPONSIBILITIES

The developer of each parcel within in the SURA District or 'district' shall be responsible for all the upkeep and maintenance of all the improvements on said property with the exception of water lines, sanitary sewer mains, and storm sewer lines which are part of the Superior/McCaslin Interchange District (SMD). In addition, the developer shall also be responsible for landscaping, maintaining, and irrigating additional open space to an adjacent curb should there be an adjacent ROW.

- Detention Facilities:**  
The developer shall also be responsible for all maintenance and upkeep of all landscaping within detention pond areas (see note B.3 below) and any underground detention facilities should they be required. If required, the developer must provide for and execute a schedule of maintenance acceptable to the Town which may also be endorsed by the Town. The Town and the SMD will also be granted access to those facilities via easements. Should parking lot detention be utilized, the depth of such detention shall be as deemed appropriate by Town staff during the FDP stage.
- The developer shall attempt to obtain a license permit from CDOT to sod and irrigate the R.O.W. and open space margin between Marshall Rd. and U.S. Highway 36.

#### B. SUPERIOR/MCCASLIN INTERCHANGE DISTRICT RESPONSIBILITIES

- Public Roadways:**
  - Marshall Road. CDOT shall maintain the paving and concrete work at Marshall Road should the roadway remain a State highway. The SMD shall maintain any and all sidewalks, landscaped medians along the road and the landscaped buffer on the south side of Marshall Road. Should the roadway become part of the Town or SMD it shall be maintained by the SMD.
  - District roads. The District shall be responsible for the maintenance and upkeep of the following roadways, and associated sidewalks proposed to be improved or constructed as part of Superior Marketplace.
    - Sycamore Street (from relocated Marshall Road to 76<sup>th</sup>).
    - 76<sup>th</sup> Street (the eastern half from Coal Creek to Marshall Road).
    - 5<sup>th</sup> Street (from Coal Creek north to Sycamore Street).
    - Coal Creek (the northern half, from 4<sup>th</sup> Street to 76<sup>th</sup> Street).
- Utilities:**
  - The District shall maintain all public water and sanitary sewer mains which are planned within the SURA District.
  - The District shall maintain all 'regional' storm water conveyances, defined as storm sewer pipes that are outlets from stormwater detention ponds, and storm sewer pipes that convey runoff from offsite areas through the property.
- Detention:**
  - The District will perform routine maintenance necessary for the ponds to function as stormwater detention facilities (e.g. sediment removal, debris removal, and mow native grasses. The District shall not maintain or repair retaining walls, mow irrigated turf, or maintain landscaping.

#### 4. Landscaped Areas:

- The District shall maintain and irrigate the following landscaped areas.
- Marshall Road medians
  - Open space buffer south of Marshall Road and Sycamore Street (to 4<sup>th</sup> Avenue).
  - Sycamore street medians.

### PROPOSED SURA DISTRICT SIGNAGE GUIDELINES

The following standards have been developed to supersede the SURA Sign Guidelines. They shall amend the Superior Sign Code Section as noted, providing some additional sign area. However, in most cases it adopts further restrictions to better control the many types of signage a tenant will propose (i.e., store within a store, sign composition, national logos, blinds, window and awning signs, etc.).

Should a particular issue arise not addressed in this guideline the Superior Sign Code as enforced on May 5, 1998, shall govern.

#### A. LEASING SIGNS (To be approved only at FDP stage)

- Number:** Three (2 at U.S. 36 frontage, 1 at McCaslin frontage).
- Size allowed:** Must be less than 8'x16' = 128 s.f. maximum sign face.
- Materials:** Paint or vinyl lettering on wood, typical.
- Lighting:** Signs may be externally illuminated with outdoor floodlights.
- Times:** Signs may remain in location selected for a period not to exceed two years from date of installation. After this time period leasing signs shall be allowed pursuant to the Superior Sign Code for temporary signs in force at that time.
- Height:** Top of sign face not to exceed 12' above finish grade.

REVISED 12-1-99  
REVISED 01-14-00  
REVISED 3-4-00  
REVISED 2-1-01  
REVISED 3-20-01  
REVISED 4-5-01  
REVISED 11-14-01  
REVISED 8-28-02  
REVISED 09-19-02

SUPERIOR MARKETPLACE	
NEW PLAN EXCEL REALTY TRUST, INC.	SHEET
THE HOLBORN GROUP, LTD.	7

Page 7 of 18



# SUPERIOR MARKETPLACE

PLANNED DEVELOPMENT/ZONE DISTRICT SITE PLAN SUBMITTAL  
NEW PLAN EXCEL REALTY TRUST, INC.

A PORTION OF THE SE 1/4 OF SECTION 13 AND THE N 1/2  
OF THE NE 1/4 OF SECTION 24, T4S, R70W OF THE 6TH P.M.



THE HULBERT GROUP, LTD.  
**AMENDMENT #4**

## B. CENTER ID MONUMENT SIGNS

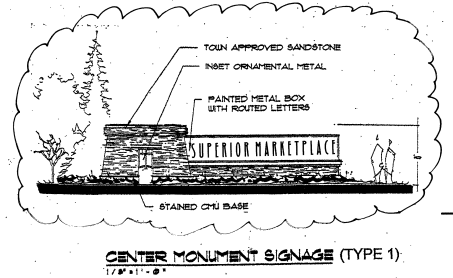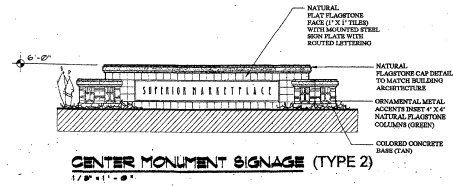


- Number: Up to two at each entry to each access to and within the SURA District.
- Size allowed: 60 s.f. maximum sign face.
- Height: Not to exceed 6'. (Architecture may exceed this by up to 2').
- Lighting: Internal or indirect external illumination. Brightness limit on any fixture related to signage to be 60 watt maximum.
- Maximum letter size: 24"
- Materials: To be Town-approved natural sandstone, with cut metal boxes similar to tenant ID signage. A CMU base of up to 18" may be introduced.
- Nomenclature: Signs shall identify development projects only. No tenant signage shall appear on Center ID signs.

## C. TENANT ID MONUMENT SIGNS

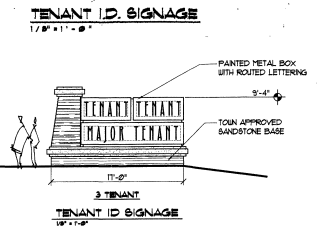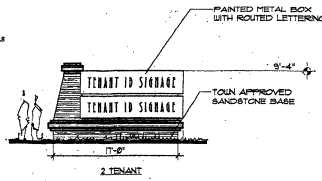

- Number: Four at U.S. 36 frontage. One at McCastin frontage.
- Box Size allowed: (2) 3'-0" x 14'-0" boxes per sign or (1) 3'-0" x 14'-0" and (2) 3'-0" x 7'-0" boxes per sign.
- Number of tenants allowed: 2/sign for 3 at U.S. 36  
2/sign for 1 at McCastin  
3/sign for 1 at U.S. 36
- Sign Area: 2'-6" x 13'-4" = 34 s.f. per box for each 2 box sign. (May be double-faced).  
(1) 2'-6" x 13'-4" = 34 s.f. plus (2) 2'-6" x 6'-4" = 32 s.f. per each 3 box sign. (May be double-faced)
- Height: Sign shall not exceed height of 9'-0" above adjacent grade at high side of sign. (Architecture may exceed this by 1'-8"). A flat grade of a minimum of 3' beyond the sign must be provided on the low side. It shall be created by use of a natural sandstone retaining wall and shall include a continuous row of foundation plantings. Note: Berming to elevate sign at high side shall not be allowed.
- Miscellaneous: Signage elements to be consistent. Cut metal boxes of like color shall be set on Town-approved sandstone. A CMU base of up to 18" shall be allowed. All tenant "boxes" will have a uniform color background, shall be internally lit and may have the tenant's name/identifiers/logo in the type, design, style or color desired by a particular tenant.
- Marshall Road Setbacks: Architecture of said signs may be located at the property line with any signage setback a minimum of three feet. Final distance from Marshall Road shall be dependent on CDOT alignment. In any case, landscaping elements will define and accentuate the separation of the signs from Marshall Road.
- McCastin Road Setbacks: Said signs shall be setback a minimum of 25' from the roadway curb and gutter.

## D. WALL SIGNS

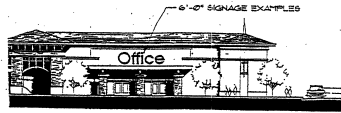

- Number: One per frontage on street, drive, parking area or landscape element. Not to exceed a total of three. Signage on walls adjoining adjacent tenants shall be allowed only if user is within one space of ROW.

\*Exception: Due to the length of the building and its entry location at the far end of the structure, Major 1 may utilize two signs on the east-facing facade, however, the maximum area of all signs on this facade shall not exceed the maximums listed below.

- Exclusion: Shall not be allowed facing Sycamore Street or 76<sup>th</sup> Street without tenant entry door or glazing located on said street. Signage on these streets, if allowed, shall not be illuminated.
- Allowable area calculation: 1.5 s.f. per linear foot of building frontage for first 100 linear feet, one s.f. per linear foot thereafter. No signage on a facade shall exceed that area allowed for a particular frontage.

Total sign area per frontage shall not exceed the following:

- Area maximum: 200 s.f./frontage for tenant less than 30,000 s.f.
- 300 s.f./frontage for tenants equal to or greater than 30,001 and less than 100,000 s.f.
- 350 s.f./frontage for tenants equal to or greater than 100,001 s.f.

In addition, no one tenant shall have an aggregate sign area of more than 600 s.f.


- Maximum allowable letter height: 3'-0" for users up to 14,999 s.f.
- 4'-0" for users 15,000 s.f. to 39,999 s.f.
- 5'-0" for users 40,000 s.f. to 79,999 s.f.
- 6'-0" for users 80,000 s.f. or greater

Note: Letter height is often further reduced by allowed sign area. Limitations of letter height typically come into play when a tenant has a very short name.

- Composition: Signage may be of more than one line, however, said signage composition shall not exceed two times the allowed letter height and be appropriate to its architectural location.
- Logos: National logos are acceptable and may be up to 1.5 times the allowed letter height. All logos are considered a part of the allowable sign area and shall not exceed 50% of allowable sign area. Logos shall be subordinate to the overall architectural design scheme of the building or monument sign which they are placed. Said logo may be a box sign. A logo may be a portion of an individual tenant's name, but cannot be the entire name.
- Stone within a sign: In this case one additional sign only shall be allowed on the major building elevation. Said sign shall be limited to 66% of the allowed letter height and shall not exceed 50 s.f. Said sign area shall fall under the allowed area maximum for the major tenant.
- Blade Signs: In addition to fascia signage each tenant shall be allowed one ornamental blade sign. This sign shall be double-faced and shall not exceed 16 s.f. per side and shall fit within a 4' x 4' square. Said sign area shall fall under total allowed sign area. The sign shall be hung via ornamental ironwork, shall be located on a column adjacent to the tenants main entry and the top of the sign shall not be mounted more than 14' above adjacent grade.
- Descriptors: Descriptors are allowed and may be located separately from main body of signage. Descriptors shall not exceed 1/2 the allowed letter height. However, no descriptors shall exceed a height of 2'. Said signage shall fall under area limitations previously listed and shall not exceed 35% of overall maximum sign area allowance. All descriptor locations outside of designated sign band area shall be placed in an appropriate architectural location and are therefore subject to Developer approval.
- Fabric awning signage: Awnings, other than backlit, are allowed. Should signage be displayed on more than one canopy it shall be repetitive. Said signage shall fall under area limitations previously listed. All awnings material shall be fabric, metal, or other approved materials. No plastic awnings shall be allowed. Awnings colors shall be repetitive, and compatible or complementary to a building's color palette.
- Window signs: One window sign per window is permitted on any face of a building. Individual letters shall be allowed and shall be "white," applied to the inside face of the window. The typestyle shall be limited to that of the primary fascia sign. All signage shall be mounted at the same elevation above finished floor. No such sign letter or composition shall exceed 8" in height and its width shall not be greater than 80% of the exposed window. The area of any single window sign shall not exceed 5% of window area on which it is mounted. The area of said signage shall combine and shall fall under area limitations previously listed and shall not exceed 20% of overall maximum sign area allowance.

- Sign area calculation: All signage area shall be defined as that area created by enclosing the signage in question by a multidated polygon composed only of 90° corners. No side of said polygon may be less than one-fourth the proposed letter height.
- Area summation: The sum of the areas of all signage types (main body, descriptor, canopy, blade, etc.) shall not exceed the allowable area calculation or area maximum for any individual user, or given frontage.

## E. DIRECTIONAL SIGNAGE

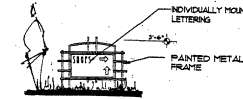

### DIRECTIONAL TENANT SIGNAGE

17'0" x 11'0"

The Superior Marketplace is composed of six major parcels with a multitude of uses and users (i.e., theater, RFD park 'n ride, major users and Town Hall). To make one's experience of this exciting project as enjoyable as possible a directional sign program shall be introduced. The program shall incorporate ornamental signs designed in a manner compatible to the architecture of the center and appropriately placed to facilitate one's movement. Major tenant names may be incorporated on the signs, however, letter height shall not exceed 8" and one typestyle shall be utilized throughout.

## F. GENERAL

- Signage shall be located in the designated sign band, as indicated on the FDP.
- Signs shall generally be individual pan channel letters. The letters shall not be less than four (4) inches nor more than five-and-one-half (5 1/2) inches in depth. National logos, or descriptors 1' or less in height, may be a box sign with similar trim details to the typical pan channel letter. All such signs shall be internally illuminated.
- Temporary window banners ("Now Open," "Sale," etc.) shall be allowed on a basis of one sign per frontage for a single period of one month in any given calendar year. Sign shall not exceed 50% of window area in which it is mounted, and shall be located entirely within tenant space.
- Other sign media shall be acceptable at Superior Marketplace as long as each sign material is deemed to be of an equal or higher standard.

## PUBLICLY DEDICATED LAND DESCRIPTIONS

The following lands (or portions thereof) shall be dedicated as a part of the Superior Marketplace development:

- The area designated as Marshall Road (+/- 100' wide R.O.W.) that crosses the proposed site. This area encompasses +/- 5.4 acres.
- The area designated as Extended Maple Street (to be renamed Sycamore, with a 60' R.O.W.) that crosses the proposed site. This area encompasses +/- 2.2 acres.
- The eastern 50% of the 76<sup>th</sup> Street R.O.W. This area encompasses +/- 1.9 acres.
- The northern 50% of Coal Creek from 4<sup>th</sup> Avenue to 76<sup>th</sup>. This area encompasses +/- 0.8 acres.
- Primary detention areas - exact sizes to be determined in the final PD and platting processes. These shall include:
  - Two detention areas west of roundabout.
  - Three large detention areas west of Marshall Road.
  - Detention area south and east of theatre buildings.

REVISED 12-1-99  
REVISED 01-14-00  
REVISED 3-1-00  
REVISED 2-1-01  
REVISED 3-20-01  
REVISED 4-5-01  
REVISED 11-14-01  
REVISED 6-29-02  
REVISED 09-19-02

SUPERIOR MARKETPLACE  
NEW PLAN EXCEL REALTY TRUST, INC.  
SHEET  
8  
THE HULBERT GROUP, LTD.  
Page 8 of 18



# SUPERIOR MARKETPLACE


Superior, Colorado

Preliminary Landscape Plan

Planned Development Zone District Plan

Amendment #4

May 14, 1998

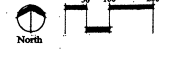

Revised May 21, 1999  
Revised November 14, 2000  
REVISED 8-1-00

**Materials Quantity Chart**



- All plant sizes listed above are minimum sizes required at time of installation.
- For the first 70% of the ground plan, a landscape plan shall be prepared based on existing site conditions and proposed improvements.
- Planting lists shall be a combination of deciduous and evergreen plants comprising 60% evergreen and 40% deciduous, and including seasonal and perennial plants.
- In a 17' buffer area, adjacent to commercial, office or retail uses, use trees per 20' Buffer Band of adjacent property line to a maximum of width 20' shall be minimum required.
- Evergreen trees and shrubs will include maintenance and beneficial program details.

**Special Planting Area Densities**

Area	Types	Shrubs
A (Area Behind Costco)	1/1,400 s.f.	1/30 s.f.
B (Roundabout Planting)	1/1,200 s.f.	1/30 s.f.
D (Planting Along Marshall Road)	1/1,000 s.f.	1/30 s.f.
E (Planting Along Marshall Road and McCullin Road)	1/1,400 s.f.	1/30 s.f.
A1 (Area Behind Major 2.3 & 4)	1/800 s.f.	1/30 s.f.
C1 (N.E. Corner of 7th & Symons)	1/375 s.f.	1/30 s.f.
B1 (Area Behind Major 4 & 7)	1/825 s.f.	1/30 s.f.
D1 (Area Along Transportation Hub)	1/1,400 s.f.	1/30 s.f.

Note: Additional quantities will not count toward overall plant quantity requirements for the project. In: parking; R.O.W.; building and perimeter.

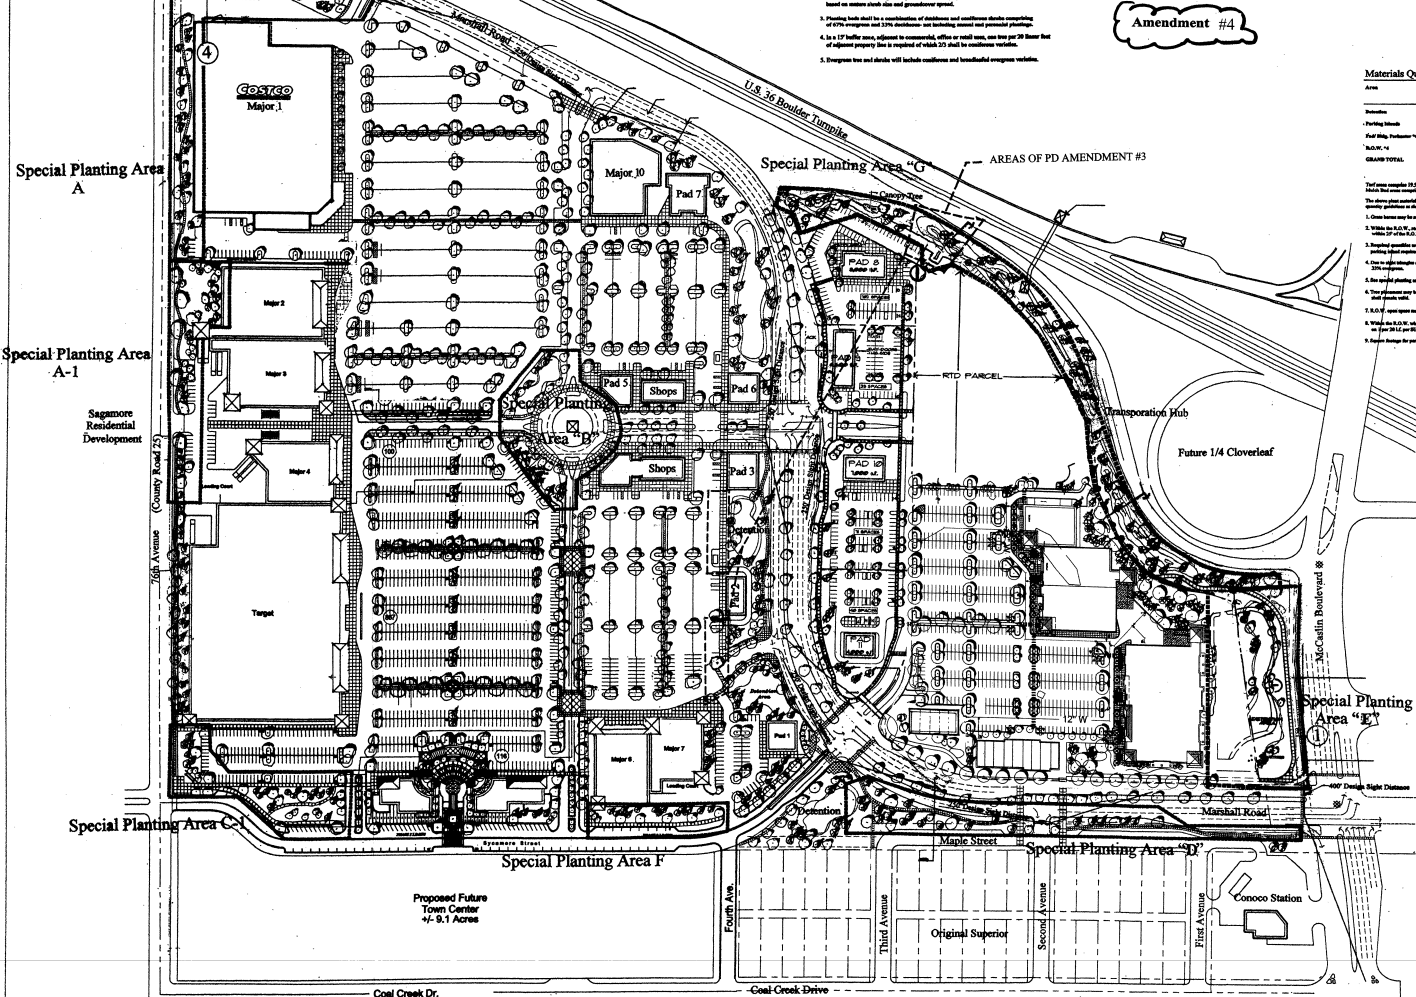

**PLANT LEGEND**

COMMON NAME	BOTANICAL NAME	LOCATION
<b>DECIDUOUS CANOPY TREES</b>		

REVISED 09-19-02  
REVISED 07/05/02  
REVISED 6-28-02  
REVISED 11-14-01  
REVISED 4-5-01  
REVISED 3-20-01  
REVISED 2-1-01

SUPERIOR MARKETPLACE

NEW PLAN EXCEL REALTY TRUST, INC.

SHEET

9 Page 9 of 18

THE HUBBARD GROUP, LP

# SUPERIOR MARKETPLACE

SUPERIOR, COLORADO

SPECIAL PLANTING AREA 'G'

PLANNED DEVELOPMENT ZONE DISTRICT PLAN


TYPICAL AREA ENLARGEMENT

AMENDMENT #4


### Area G

	Area	Ratio
Total Area	121,604 s.f.	
Bed Area***	24,280 s.f.	
Trees*	1 / 1,400 s.f.	
Shrubs**	1 / 30 s.f.	

Note: One tree may be substituted for 10 shrubs.  
 Plan reflect shrub quantities @ 1/50 s.f.  
 Tree ratios are for the total area and shrub ratios are for bed area only.  
 \* The total tree quantities are divided into 33% deciduous and 67% evergreen.  
 \*\* The total shrub quantities are divided into 33% deciduous and 67% evergreen.  
 \*\*\* Bed area is subject to change and should be planted accordingly.  
 Quantities shown may meet or exceed requirements of Special Planting Areas.

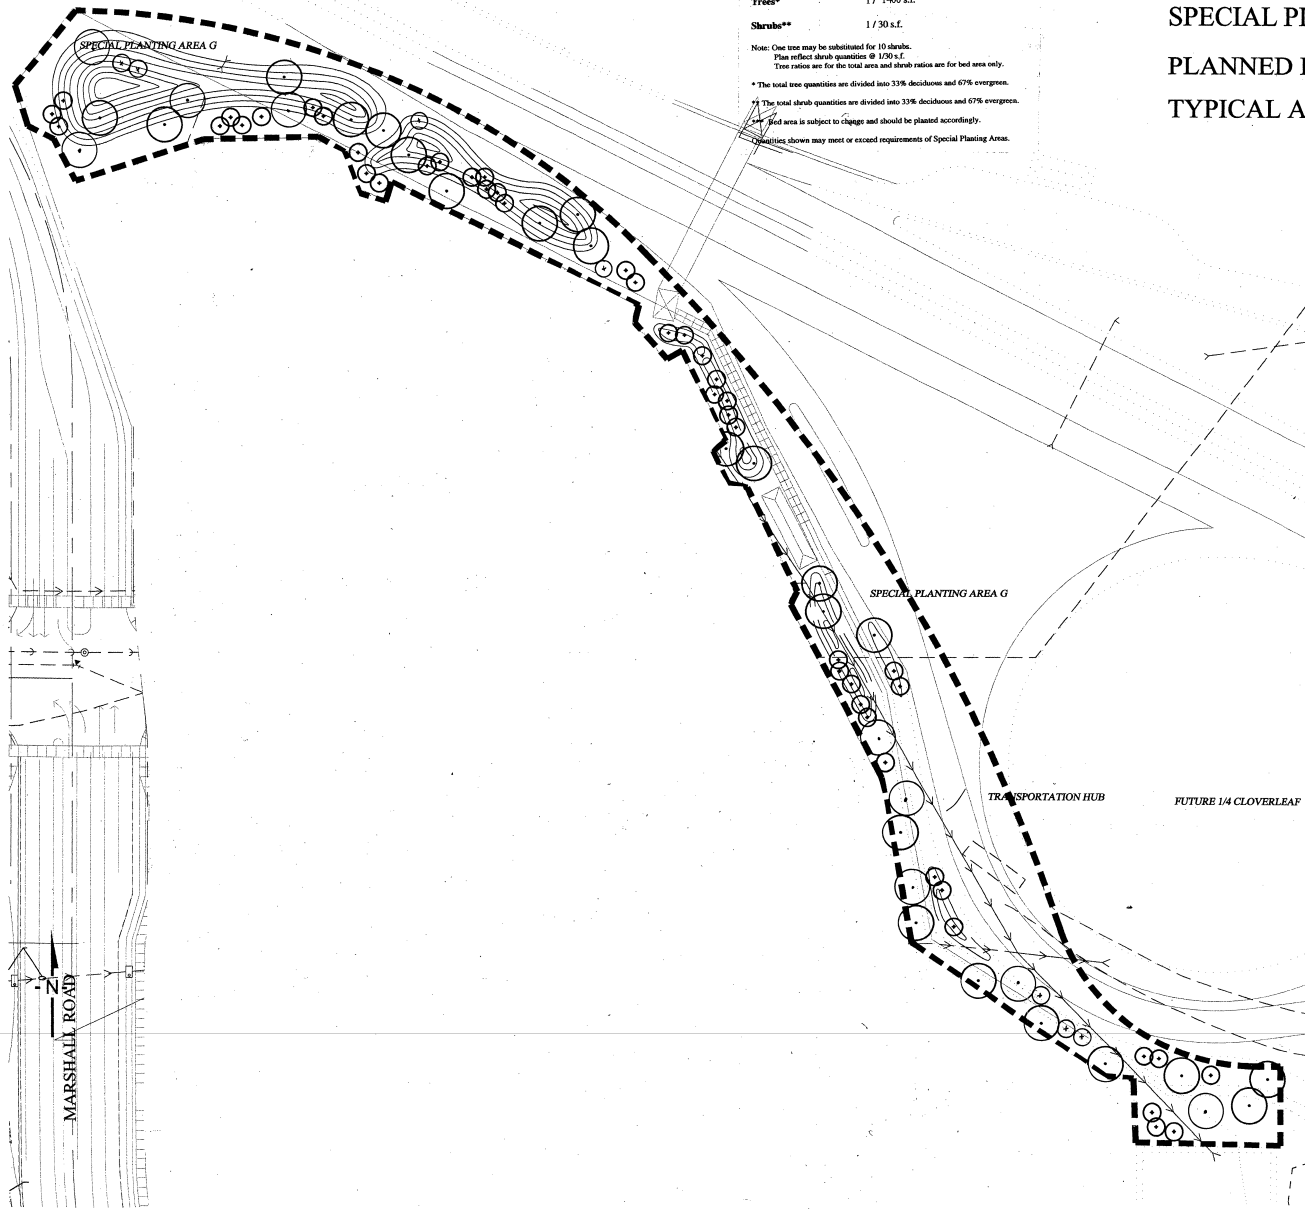

REVISED 3-20-01 MAY 21, 1999  
 REVISED 4-5-01 REVISED JANUARY 14, 2000  
 REVISED 11-14-01 REVISED 3-1-00  
 REVISED 6-28-02 REVISED 2-1-01  
 REVISED 09-19-02

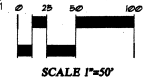

The  
 NORMAN DULLEA  
 Company  
 ARCHITECTS  
 Planning  
 Landscape Architecture  
 750 West Colfax  
 Denver, Colorado 80204  
 Fax: 303 892 1186  
 Phone: 303 892 1166

SUPERIOR MARKETPLACE	
NEW PLAN EXCEL REALTY TRUST, INC.	SHEET 9.1 Page 10 of 16
THE HANSON GROUP, INC.	


# SUPERIOR MARKETPLACE

SUPERIOR, COLORADO


PLANNED DEVELOPMENT ZONE DISTRICT PLAN  
SITE SECTIONS

AMENDMENT #4


REVISED JANUARY 14, 2000  
REVISED 3-1-00  
REVISED 2-1-01  
REVISED 3-20-01  
REVISED 4-5-01  
REVISED 11-14-01  
REVISED 6-28-02  
REVISED 09-19-02

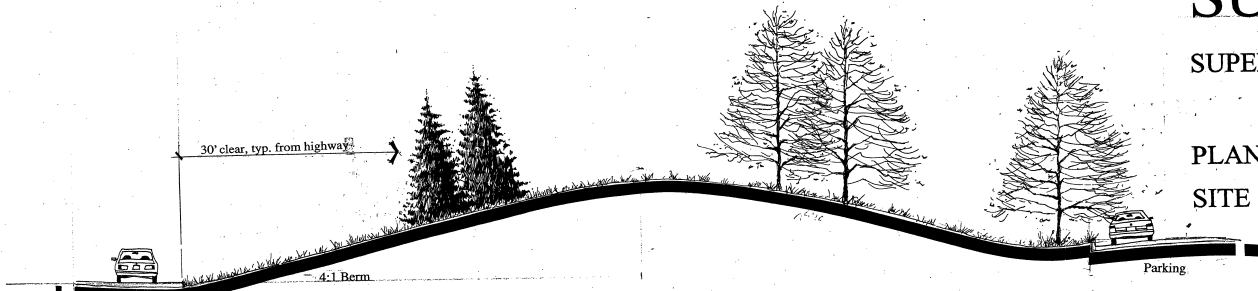

Section 1  
Scale 1/8"=1'-0"

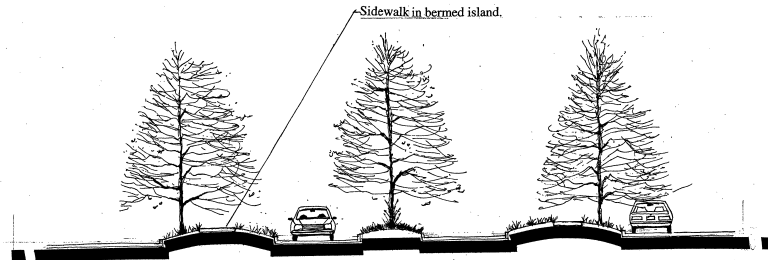

Section 2  
Scale 1/8"=1'-0"

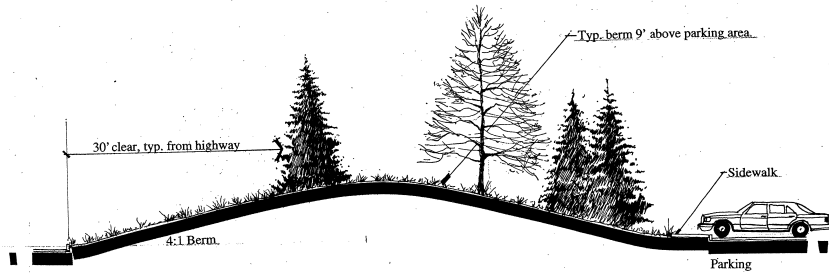

Section 3  
Scale 1/8"=1'-0"

SUPERIOR MARKETPLACE

NEW PLAN EXCEL  
REALTY TRUST, INC.

SHEET

Special Planting Area "G"

THE HUBBARD GROUP, INC.


9.2 Page 11 of 18

# SUPERIOR MARKETPLACE

## PD AMENDMENT #4

### Superior, Colorado

May 14, 1998

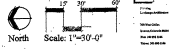


### Special Planting Area "A"


Area A		
	Area	Ratio
Total Area	9730 s.f.	
Bed Area***	2631 s.f.	
Trees**	17,149 s.f.	
Shrubs**	1736 s.f.	

Note: Plant may be substituted for 1:1 ratio.  
Plant selection should consider @ 1.50 s.f.  
The ratio for the total area and shrub ratio are for the bed area only.

\* The total tree quantities are divided into 25% deciduous and 75% evergreen.  
\*\* The total shrub quantities are divided into 25% deciduous and 75% evergreen.  
\*\*\* Bed area is subject to change and should be planted accordingly.  
Quantities shown may indicate allowed replacement of Special Planting Area location.

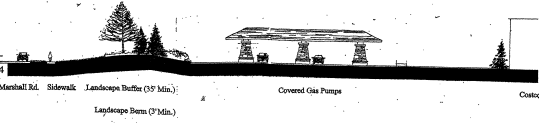

4 Section

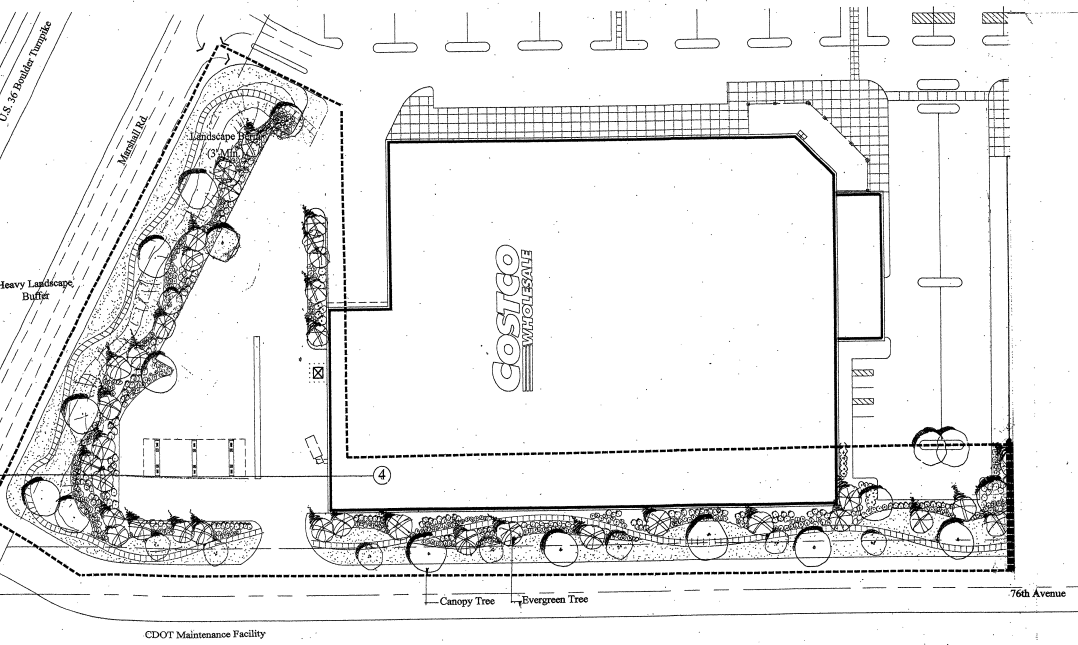

REVISED 09-19-02  
 REVISED 11-14-01  
 REVISED 6-28-02  
 REVISED 2-1-01  
 REVISED 3-20-01  
 REVISED 4-5-01  
 REVISED 12-1-99  
 REVISED 01-14-00  
 REVISED 3-1-00

### SUPERIOR MARKETPLACE

NEW PLAN EXCEL  
 REALTY TRUST, INC.

# SHEET


10 Page 12 of 18

THE HUBBARD GROUP, LTD.

# SUPERIOR MARKETPLACE

SUPERIOR, COLORADO

MAY 21, 1999

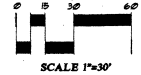

Planning  
Landscape Architecture  
710 West Colfax  
Denver, Colorado 80204  
Tel: 303.892.1100  
Fax: 303.892.1166

## SPECIAL PLANTING AREA 'A1'

### PLANNED DEVELOPMENT ZONE DISTRICT PLAN

### TYPICAL AREA ENLARGEMENT

### PD AMENDMENT #4

Area A1

	Area	Ratio
--	------	-------

Total Area	25075 s.f.	
------------	------------	--

Bed Area***	12675 s.f.	
-------------	------------	--

Trees*	1/800 s.f.	
--------	------------	--

Shrubs**	1/30 s.f.	
----------	-----------	--

Note: One tree may be substituted for 10 shrubs.

Plan reflects shrub quantities @ 1/30 s.f.

Tree ratios are for the total area and shrub ratios are for the bed area only.


\* The total tree quantities are divided into 33% deciduous and 67% evergreen.

\*\* The total shrub quantities are divided into 33% deciduous and 67% evergreen.

\*\*\* Bed area is subject to change and should be planted accordingly.

Quantities shown may meet or exceed requirements of Special Planting Area densities.

For Final Crosswalk Plan, see Sheet 2

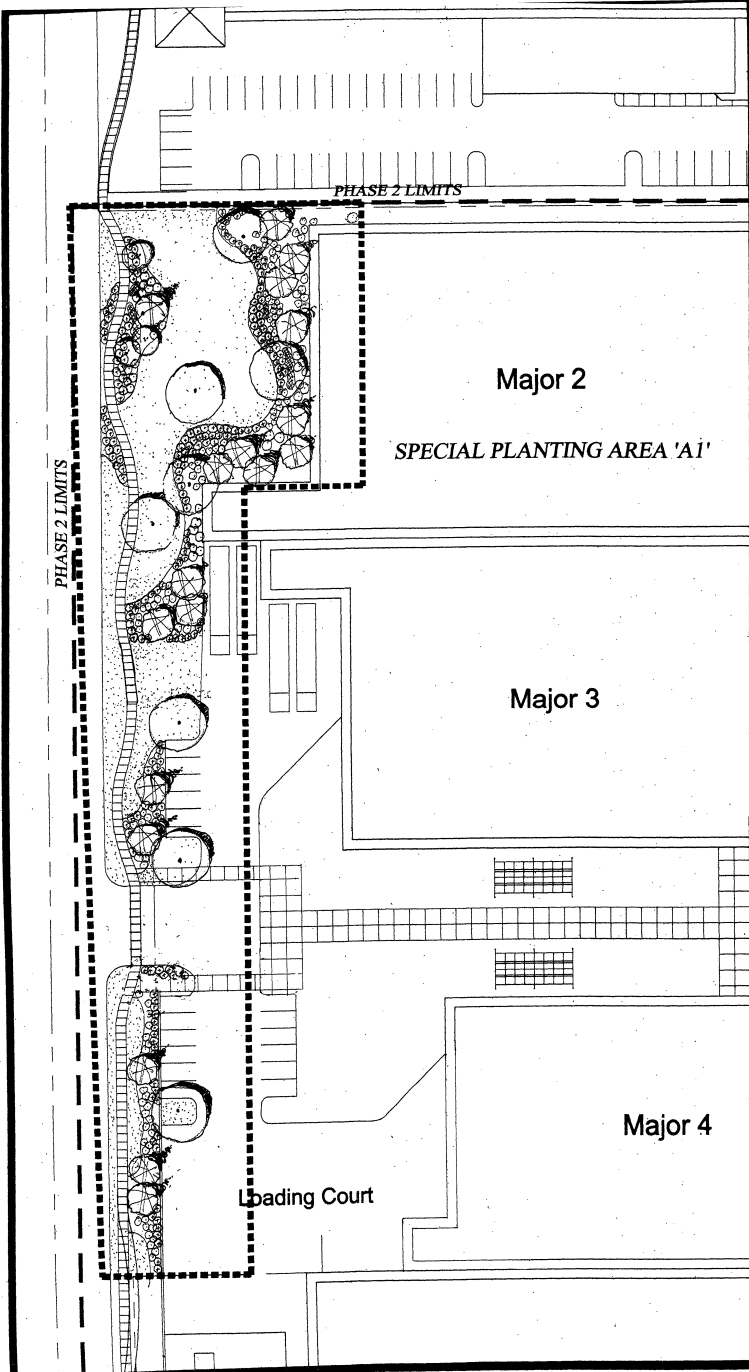

11.4.99 REVISION

10/1/99 PLAN REVISION

8.23.99 PLAN REVISION

REVISED 11-30-99

REVISED 12-1-99

REVISED 01-14-00

REVISED 3-1-00

REVISED 2-1-01

REVISED 3-20-01

REVISED 4-5-01

REVISED 11-14-01

REVISED 6-28-02

REVISED 09-19-02

SUPERIOR MARKETPLACE

NEW PLAN EXCEL  
REALTY TRUST, INC.

SHEET

THE HOLLER GROUP, LTD.

11 Page 13 of 18

# Superior Marketplace


Superior, Colorado

Typical Area Enlargement

Planned Development Zone District Plan

Special Planting Area "B"

May 14, 1998

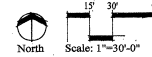


Area B		
	Area	Ratio
Total Area	38,487 s.f.	
Bed Area***	8,300 s.f.	
Trees*	1/1,500 s.f.	
Shrubs**	1/30 s.f.	

Note: One tree may be substituted for 10 shrubs.  
 Plan reflects shrub quantities @ 1/20 s.f.  
 Tree ratios are for the total area and shrub ratios are for the bed area only.

\* The total tree quantities are divided into 40% deciduous and 60% evergreen.  
 \*\* The total shrub quantities are divided into 33% deciduous and 67% evergreen.  
 \*\*\* Bed area is subject to change and should be planted accordingly.  
 Quantities shown may meet or exceed requirements of Special Planting Area details.

AMENDMENT #4

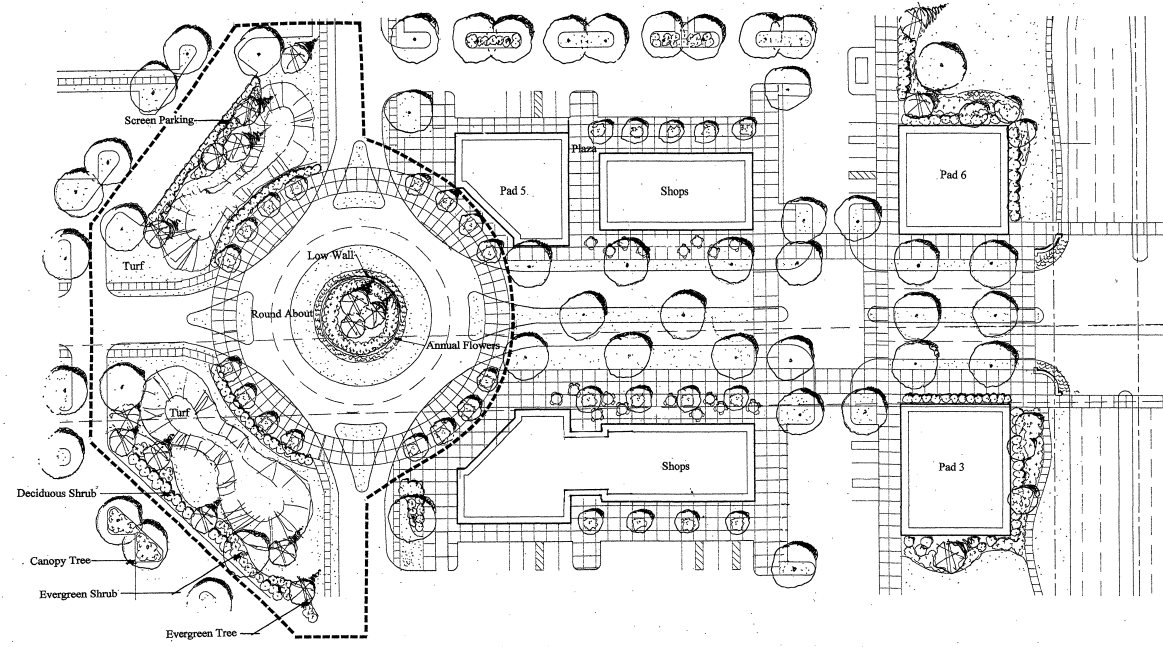

Round About Plantings

- REVISED 12-1-99
- REVISED 01-14-00
- REVISED 3-1-00
- REVISED 2-1-01
- REVISED 3-20-01
- REVISED 4-5-01
- REVISED 11-14-01
- REVISED 6-29-02
- REVISED 09-19-02

SUPERIOR MARKETPLACE

NEW PLAN EXCEL  
 REALTY TRUST, INC.

SHEET

12 Page 1 of 18


THE HULBECK GROUP, LTD.



# SUPERIOR MARKETPLACE

SUPERIOR, COLORADO

REVISED 2-1-01 MAY 21, 1999  
 REVISED 3-20-01 REVISED JANUARY 14, 2000  
 REVISED 4-4-01 REVISED 3-1-00  
 REVISED 11-14-01  
 REVISED 6-28-02  
 REVISED 09-19-02

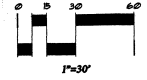



Planning  
 Landscape Architecture  
 750 West Colfax  
 Denver, Colorado 80204  
 Tel: 303 862 1166  
 Fax: 303 862 1166

## SPECIAL PLANTING AREA 'C1' & 'F' PLANNED DEVELOPMENT ZONE DISTRICT PLAN TYPICAL AREA ENLARGEMENT

**AMENDMENT #4**

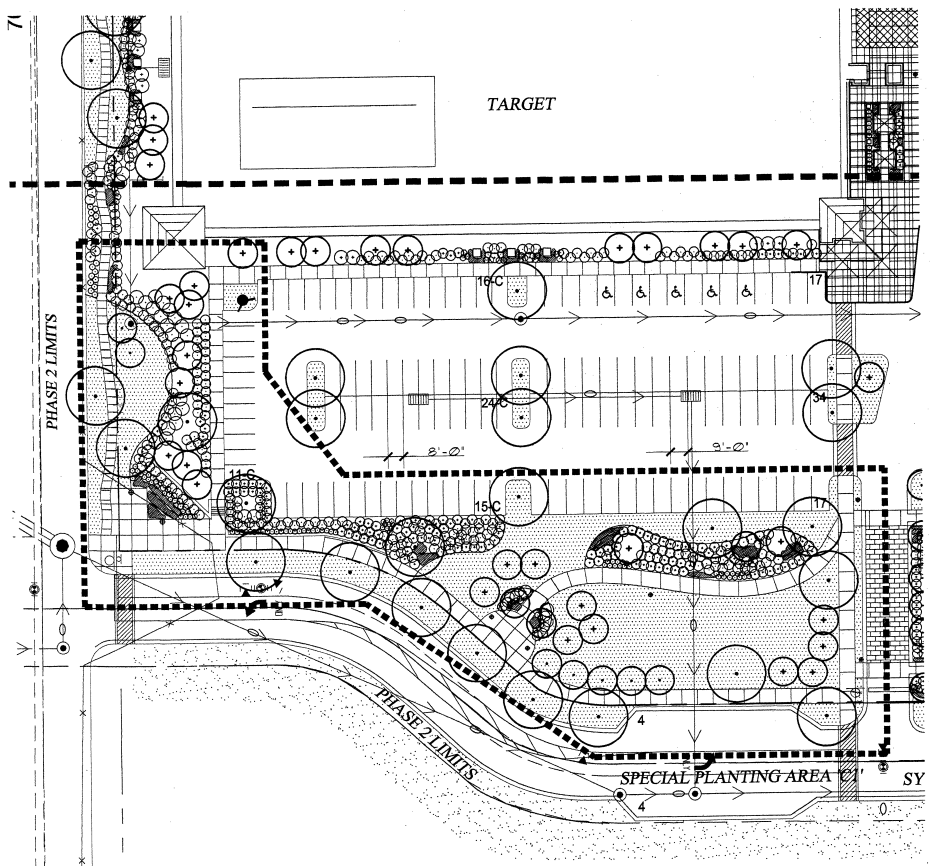


### Area F

	Area	Ratio
Total Area	11554 s.f.	
Bed Area***	6100 s.f.	
Trees*	1825 s.f.	
Shrubs**	1/30 s.f.	

Note: One tree may be substituted for 10 shrubs.  
 Plus reduce shrub quantities @ 1/30 s.f.  
 Tree ratios are for the total area and shrub ratios are for the bed area only.

\* The total tree quantities are divided into 33% deciduous and 67% evergreen.  
 \*\* The total shrub quantities are divided into 33% deciduous and 67% evergreen.  
 \*\*\* Bed area is subject to change and should be planned accordingly.

Quantities shown may meet or exceed requirements of Special Planting Area densities.

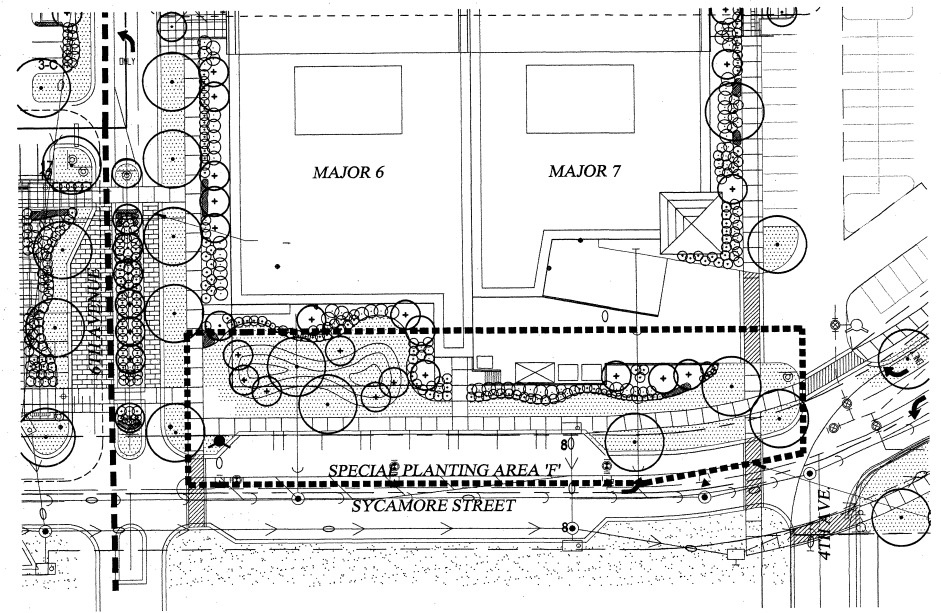

### Area C-1

	Area	Ratio
Total Area	17369 s.f.	
Bed Area***	7370 s.f.	
Trees*	1/575 s.f.	
Shrubs**	1/30 s.f.	

Note: One tree may be substituted for 10 shrubs.  
 Plus reduce shrub quantities @ 1/30 s.f.  
 Tree ratios are for the total area and shrub ratios are for the bed area only.

\* The total tree quantities are divided into 33% deciduous and 67% evergreen.  
 \*\* The total shrub quantities are divided into 33% deciduous and 67% evergreen.  
 \*\*\* Bed area is subject to change and should be planned accordingly.

Quantities shown may meet or exceed requirements of Special Planting Area densities.

## SUPERIOR MARKETPLACE

NEW PLAN EXCEL  
 REALTY TRUST, INC.

# SHEET

13

Page 159 of 18

THE HARBOR GROUP, INC.

# Superior Marketplace

Superior, Colorado

May 14, 1998



Scale: 1"=30'-0"

Typical Area Enlargement

Planned Development Zone District Plan **AMENDMENT #4**

## Area D

	Area	Ratio
Total Area	28,723 s.f.	
Bed Area***	13,740 s.f.	
Trees*	1/1,000 s.f.	
Shrubs**	1/30 s.f.	

Note: One tree may be substituted for 10 shrubs.  
Plan reflects shrub quantities @ 1/70 s.f.  
Tree ratios are for the total area and shrub ratios are for the bed area only.


- \* The total tree quantities are divided into 33% deciduous and 67% evergreen.
  - \*\* The total shrub quantities are divided into 33% deciduous and 67% evergreen.
  - \*\*\* Bed area is subject to change and should be planned accordingly.
- Quantities shown may meet or exceed requirements of Special Planting Area designation.

## Area E

	Area	Ratio
Total Area	27,000 s.f.	
Bed Area***	5,800 s.f.	
Trees*	1/1,000 s.f.	
Shrubs**	1/30 s.f.	

Note: One tree may be substituted for 10 shrubs.  
Plan reflects shrub quantities @ 1/70 s.f.  
Tree ratios are for the total area and shrub ratios are for the bed area only.

- \* The total tree quantities are divided into 33% deciduous and 67% evergreen.
  - \*\* The total shrub quantities are divided into 33% deciduous and 67% evergreen.
  - \*\*\* Bed area is subject to change and should be planned accordingly.
- Quantities shown may meet or exceed requirements of Special Planting Area designation.

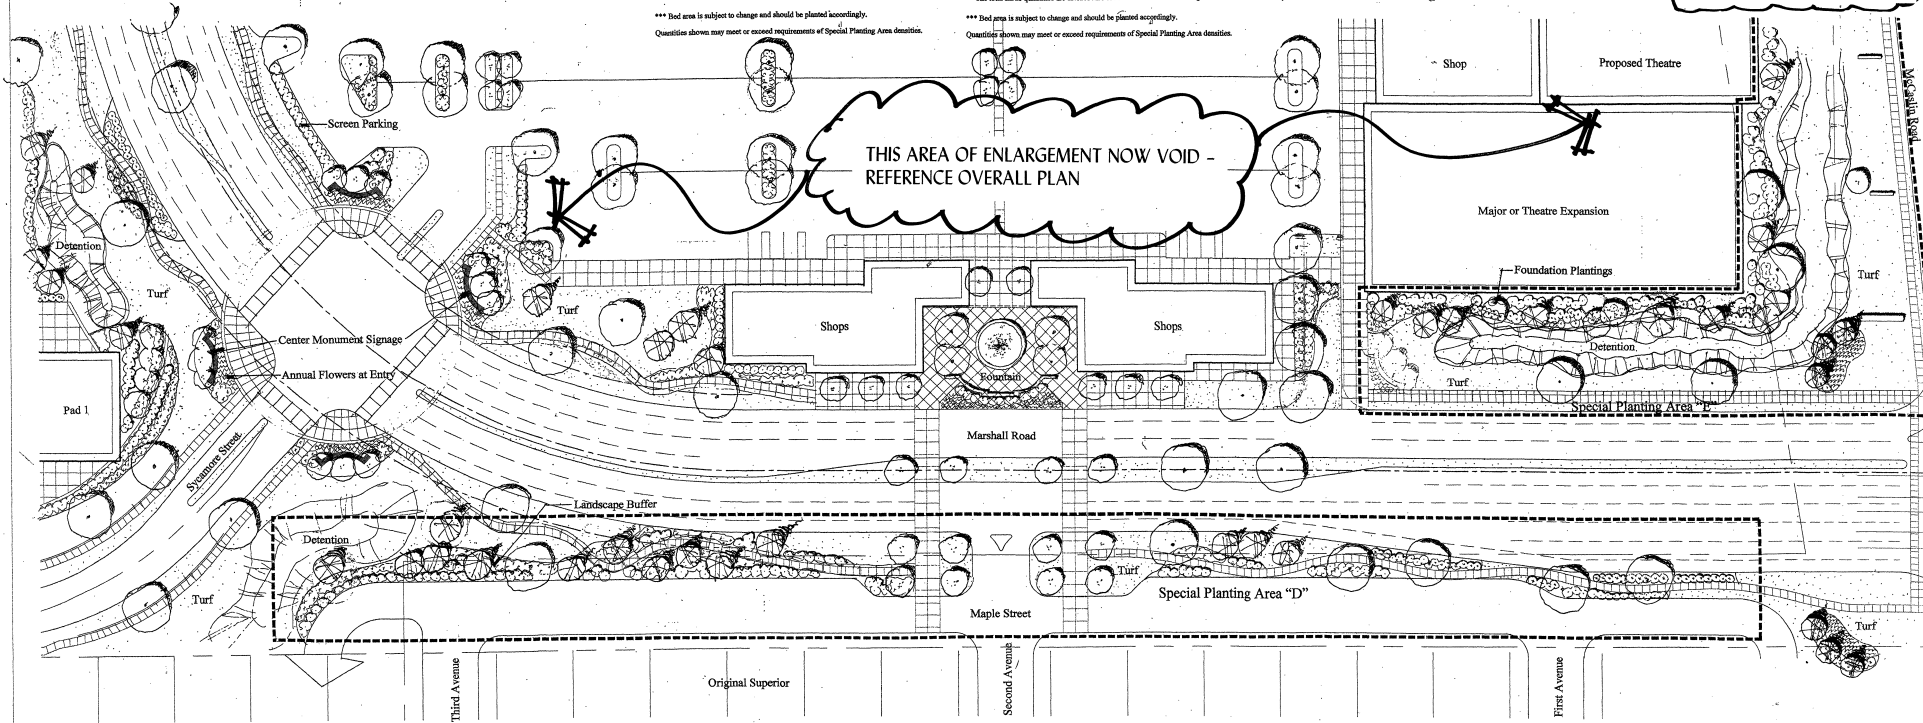

Marshall Road Streetscape  
Special Planting Area "D" and Partial "E"

REVISED 12-1-99  
REVISED 01-14-00  
REVISED 3-1-00  
REVISED 2-1-01  
REVISED 3-20-01  
REVISED 4-5-01  
REVISED 11-14-01  
REVISED 6-28-02  
REVISED 09-19-02

SUPERIOR MARKETPLACE

NEW PLAN EXCEL  
REALTY TRUST, INC.

SHEET

14 Page 169 of 18

THE HULCHER GROUP, LTD.

# Superior Marketplace

Superior, Colorado


PD AMENDMENT #4

Typical Sections


1/8"=1'-0"

May 14, 1998



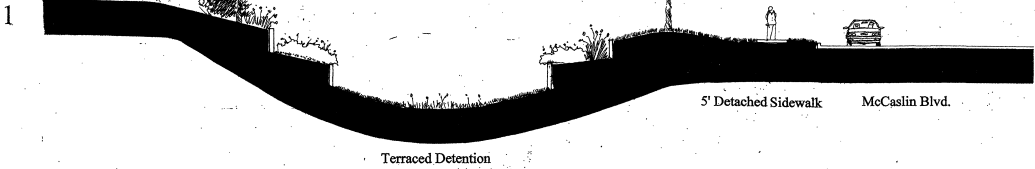

• Section Looking North at McCaslin Blvd.

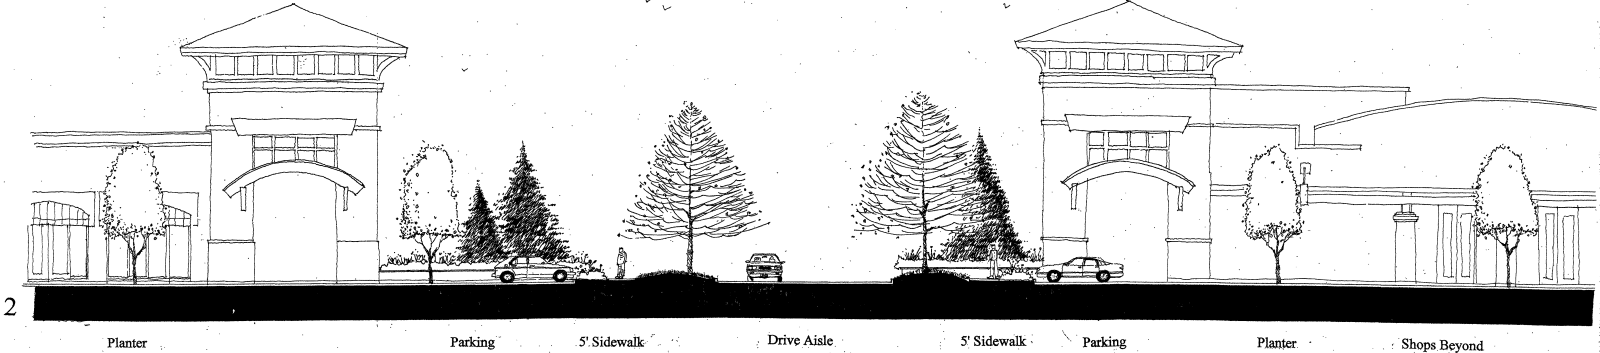

• Section Looking West Thru Main Drive Aisle/ Typical Pedestrian Way

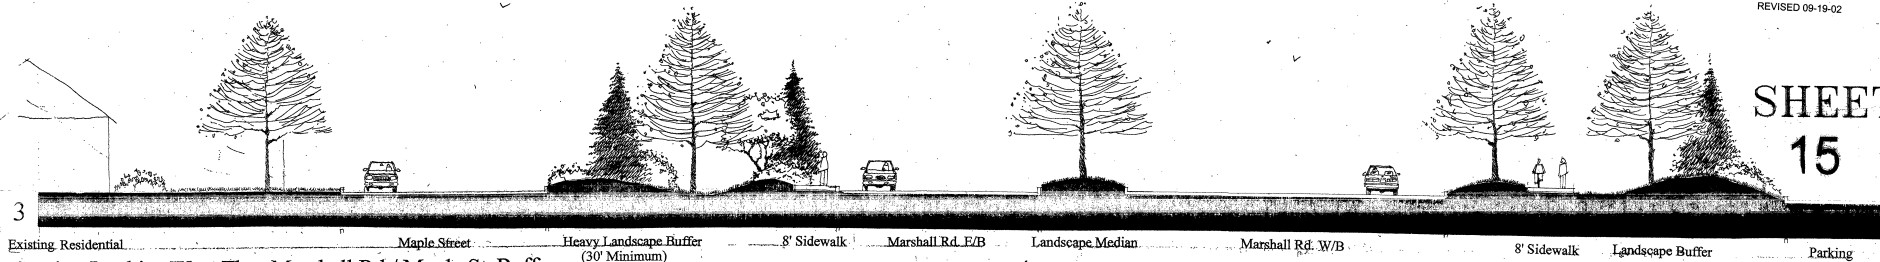


• Section Looking West Thru Marshall Rd./ Maple St. Buffer

REVISED 12-1-99  
 REVISED 01-14-00  
 REVISED 3-1-00  
 REVISED 2-1-01  
 REVISED 3-20-01  
 REVISED 4-5-01  
 REVISED 11-14-01  
 REVISED 6-28-02  
 REVISED 09-19-02



SHEET  
 15

# SUPERIOR MARKETPLACE
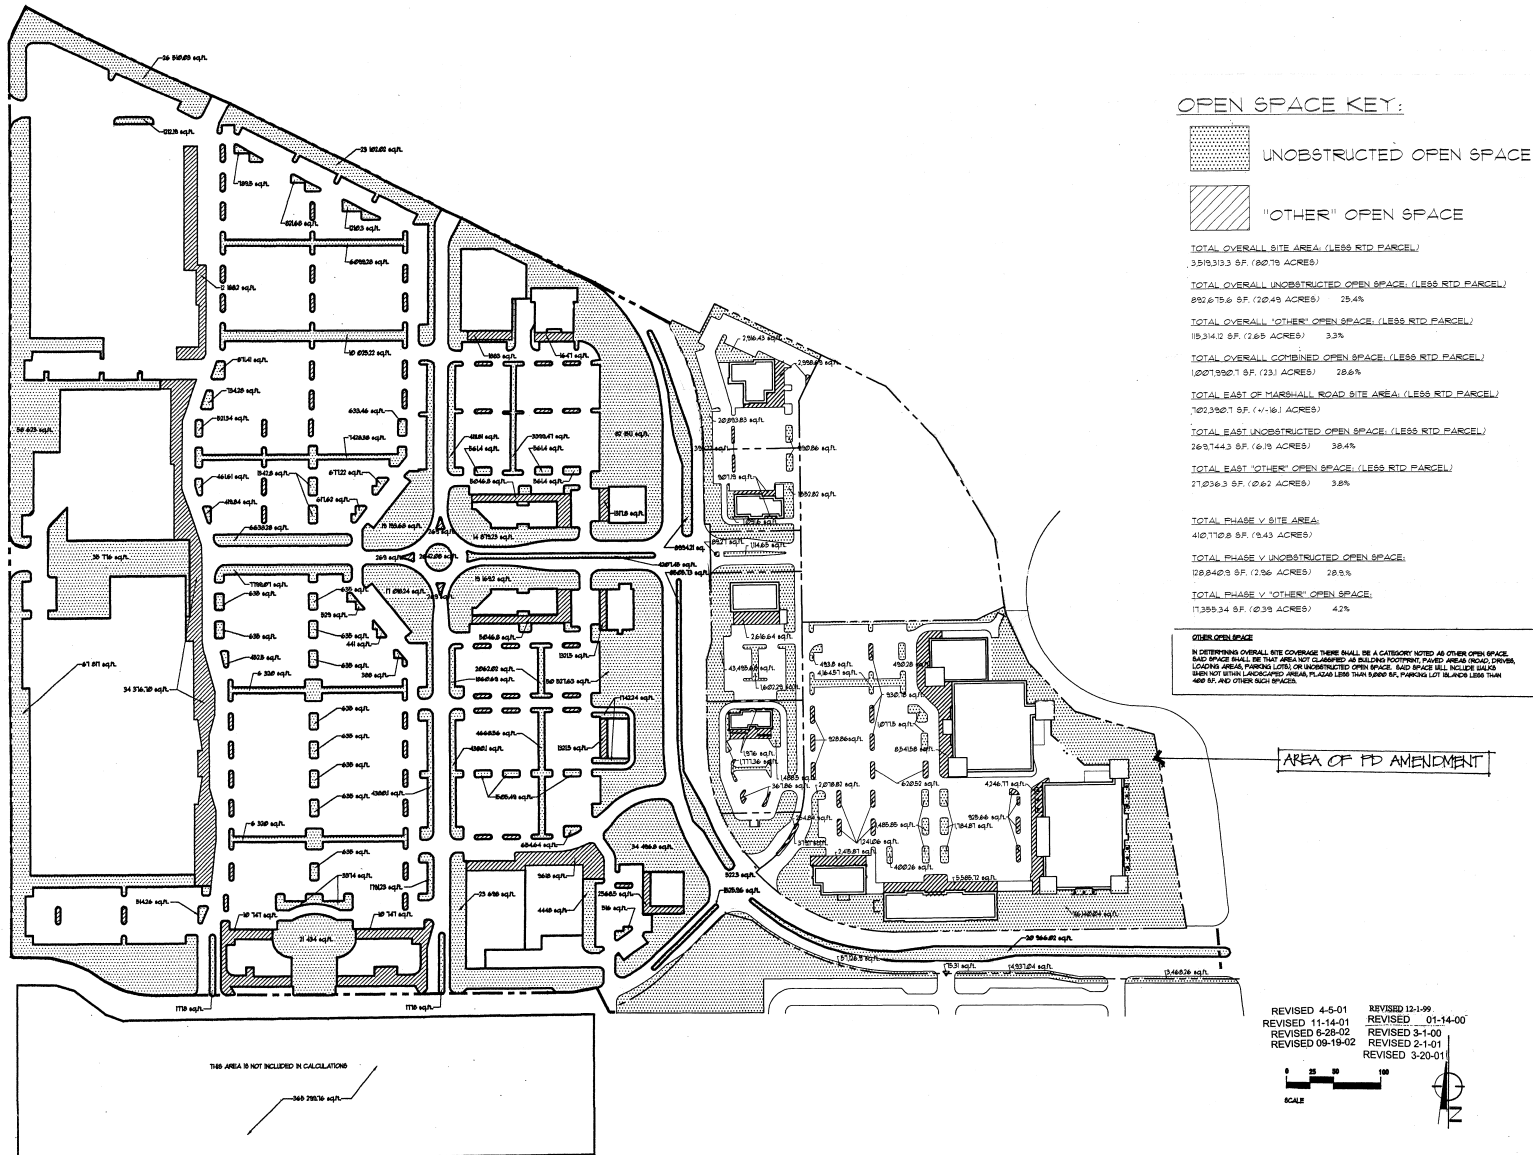
## OPEN SPACE CALCULATIONS AMENDMENT #4



### OPEN SPACE KEY:

-  UNOBSTRUCTED OPEN SPACE
-  "OTHER" OPEN SPACE











**OTHER OPEN SPACE**  
IN DETERMINING OVERALL SITE COVERAGE THERE SHALL BE A CATEGORY NOTED AS OTHER OPEN SPACE. THIS SPACE SHALL BE THE AREA NOT CLASSIFIED AS BUILDING FOOTPRINT, PAVED AREA (WALK, DRIVE, LOADING AREA, PARKING LOT), OR UNOBSTRUCTED OPEN SPACE. THIS SPACE WILL INCLUDE BUT NOT BE LIMITED TO: LANDSCAPE AREAS, PLAZAS LESS THAN 5000 SF, PARKING LOT BLACKS LESS THAN 400 SF, AND OTHER SUCH SPACES.

AREA OF PD AMENDMENT

THIS AREA IS NOT INCLUDED IN CALCULATIONS

- REVISED 4-5-01
- REVISED 11-14-01
- REVISED 6-28-02
- REVISED 09-19-02
- REVISED 12-1-99
- REVISED 01-14-00
- REVISED 3-1-00
- REVISED 2-1-01
- REVISED 3-20-01



SUPERIOR MARKETPLACE  
SUPERIOR, COLORADO

The information contained in this drawing is intended for use only on the project, identified herein. It is not to be used for any other project without the written consent of The Mulhern Group, L.P. The Mulhern Group, L.P. reserves the right to make changes to or use of the information contained herein without notice. The Mulhern Group, L.P. does not warrant the accuracy of the information contained herein, including all typographical errors. The Mulhern Group, L.P. shall not be liable for damages, including consequential damages, arising out of or in connection with the use or performance of the drawing and its delivery means.

DATE	REVISION
5.4.99	TOP SUBMITTAL II
8.10.99	REVISION
8.23.99	REVISION
12.01.99	REVISION

SUPERIOR MARKETPLACE  
PROJECT NUMBER: 99010  
DRAWN BY: R/W  
CHECKED BY: DO/MGM  
DESCRIPTION: SITE PLAN